


GREENE MISSISSIPPI BOARD OF WATER COMMISSIONERS

L 6 (6)
5-12-62

WATER WELL DRILLERS LOG

Date: May 12, 1962, Driller: Porter Drilling & Supply Co. Greene
(Name) Waynes

(1) Owner of Land	Description & Color of Materials Sand, Clay, Red Clay, Shell, etc.	Thick- ness Feet	Depth Feet
<u>Fletcher Belmont</u> <small>(Name)</small>	<u>red clay</u>	<u>19</u>	<u>19</u>
<u>Rt 4 Waynesboro</u> <small>(Address)</small>	<u>sand</u>	<u>13</u>	<u>32</u>
(2) Location: $\frac{1}{4}$, $\frac{1}{4}$, Sec. <u>21</u> T <u>3</u> ^N R <u>6</u> ^W			
<u>3</u> miles <u>NW</u> , of <u>Leaksville</u> <small>(distance) (direction) (Nearest Town)</small>			
(3) Topography: <u>Hilly</u> <small>(Hilly) (Flat) (Level)</small>			
(4) Purpose of Well: <u>domestic</u> <small>(Domestic Irrigation Municipal, Industrial, Other)</small>			
Information upon completion of well:			
(1) Diameter <u>2</u> inches.			
(2) Total Depth <u>30</u> feet.			
(3) Water Level <u>18</u> feet below top of ground.			
(4) Cased to <u>24</u> , Size <u>2</u> "			
(5) Screen: Size <u>1 1/4</u> , Length <u>6</u>			
(6) Were any formations sealed against pollution?			
<u>no</u>			
If YES depth of formation _____			
Why _____			
Drillers Remarks: _____			

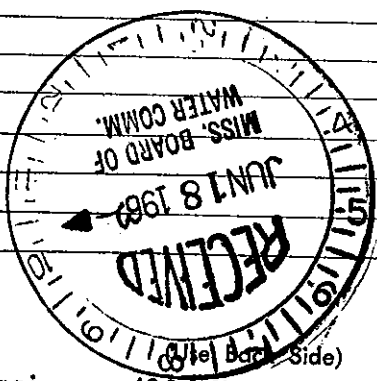

Well No. _____

Mail this copy to Board of Water Commissioners 429 Miss. St. Jackson, Miss