County: Green Permit #: Office of Land a Driller COSt Water Wellsev . P.O. E Jackson, M Date drilling completed: 10-14-08 (601) (601) 35	fell Report art 1 t of Environmental Quality nd Water Resources Sox 10631 (S 39289-0631 961-5210 4-6938 (fax)	For Office Use Only: Aquifer:				
State Law requires that this report be prepared by the 30 days of completion of drilling of the well.	driller in detail and filed w	ith the Department within				
Well Owner Information	Wel	Location				
Owner Name LOUIS FAULK	Latitude: 3 . 1 '96	" Longitude:088 • 35 <u>· 543</u> "				
Mailing Address: Industrial Park Rd	Method of Lat/Long (circle or					
	USGS quad, Hand-held	GPS Survey-grade GPS				
Leakusville, Ms 39451 City State Zip Code	Nw 1/4 NE 1/4 Sec. 33	Twn 3 Rng 6				
Telephone No. 238) 218 - 2600	Distance Direction	Nearest Town of LOAKESU. I.e.				
Well I	Data Pr.NO					
Purpose of Well (circle one) Industrial Public Supply	Irrigation Fish Culture	Other:				
Date well drilling started: 10-14-08 Date well drilling completed: 10-14-08						
If flowing, method of flow regulation: Valve N/A Other (describe)						
Static Water Level: _50feet above or relow (circle one) I	and surface Date measured:	10-14-08				
Method of Measurement (circle one) steel tape electric tape (air line) other:						
Hole depth:						
Type of grout (circle one): Cement Bentonite Mix						
Casing length: 101feet Casing diameter: 4inches Type of casing: PVC						
Screen length:						
Screen slot size: 1005 inches Setting depth: From 0 feet to 3 feet						
Type of completion (circle all applicable): Gravel packed Underreamed Telescoped Open hole Natural Development						
Other (describe):						
Top of lap pipe or reduction in casing:						
Logs run (circle all applicable): No log run Electric Gamma Ray Density Sonic Neutron Other:						
Name of organization minning log(s): N/A						
I certify that the well was drilled, constructed, and completed in accordance with all applicable requirements of the Adverse in E Department of Environmental Quality and/or the Mississippi Department of Health regulations and state laws.						
		OCT 2 3 2008				
Jack Ridgdell 0-472	- And 1	BY: OLWR				
Print Name of Water Well Contractor and License No.	Signature of	Water Well Contractor				
Nore: 1/2 mile EAST OF PRISON & Huy 63 ON FADUSTRIAL PARK RO GAR TO Right, Well 14 mile INSING GATE BY ROND. DONTHAVE A Greene Couvery MAP TO GET TOWNSHIP SECTION & RANGE GPS RADINGS						
GATE TO Right, Well 14 mile insise gate By POUD. DOWTHAVE						
A Greene County Interp to Ger Toursup action (The Je Cito Part 1-						
ONLY.						

*

L 2


6-43

If well telescopes please sketch below and show depths.

Grou

und Level	Description of Formations Encountered	From	To
und Level	TOSOIL Drange Clay Fron Kock Orange Coarse Sand Fron Rock Blue Clay Brown Coarse Sand Blue Clay Orange Coarse Sand		

If more than one screen, show location of each on sketch

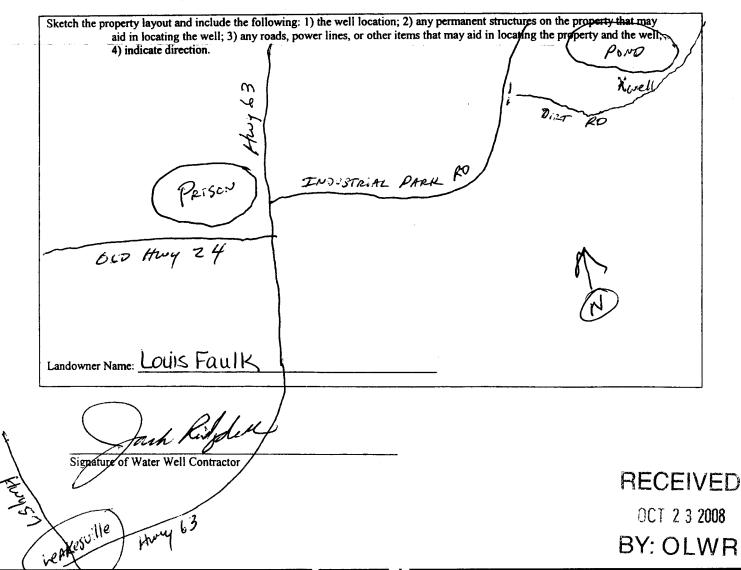

STATE WELL REPORT					
County Green Permit #: Driller COAST Water WellsR	Part 2 Pump Installer's Completion Report Mississippi Department of Environmental Quality Office of Land and Water Resources P.O. Box 10631 Jackson, MS 39289-0631		For Office Use Only: Aquifer: Weil #: <u>L- 43</u>		
Date completed: 10-14-08	(601) 961-5210 (601) 354-6938 (fax)		Elevation:		
This report should be prepared by the pump installer in detail and filed with the Department within 30 days of the					
installation of pump.					
Well Owner Informa	tion	we Latitude: 31°11'096'	Il Location $(100^{\circ} 2 \varepsilon^{\prime} \varepsilon^{\prime})$		
Owner Name: LOUIS FAULK		Latitude: 1 1 1/10	_Longitude:		
Mailing Address: Indikitria	Park Rd.	Method of Lat/Long (circle or	ne): Conventional Survey,		
		USGS quad, Hand	d-held GPS Survey-grade GPS		
Leakesville,	M_{s} 3945	¼¼ Sec	TwnRng		
City State	Zip Code	Distance Direction	Nearest Town		
Telephone No. 208) 2 18 - 260	\sim	/ Miles NE	of LEAMESUILLE		
Telephone No.	<u> </u>				
Pump Type			wer Type		
Circle one		C	Circle one		
Air Lift Jet	Submersible	Diesel Engine Gasoli	ne Engine Natural Gas		
Bucket Piston	Turbine	Electric Motor Hand	Tractor PTO		
Centrifugal Rotary	Flowing Well	Windmill Other	(specify):		
Other (specify):		Horse Power Rating of Motor	- JHP		
Date Pump Installed: 10-21-C	8	Setting Depth: 100FT.D	rop pipe feet		
Rated Pump Capacity: 35	Gallons Per Minute	Number of Stages: 9			
Pump Test Data			easuring Water Level		
Date Well Tested: 10-21-08		C C	ircle one		
.1-	t Below Land Surface	Air Line Electric Mea	asuring Line Steel Tape		
Pumping Water Level (B): <u>N/A</u> Feet		Other (specify):	· · · · · · · · · · · · · · · · · · ·		
Drawdown [(B) – (A)]: N/A Feel		For flowing well, measured sl			
Test Pumping Rate:42		Well yielded <u>50</u>	1		
Duration of Pump Test (minimum 4 hours)	: <u>6 14</u> hours	NAfeet after	NA hours of pumping		
	·····	I	· · · · · · · · · · · · · · · · · · ·		
I HEREBY CERTIFY that the above statements are true to the best of my knowledge.					
Jack Ridgdell 0-	472	f my knowledge.	dell-		
Print Name of Pump Installer and License	No. (if applicable)	Signature of Pump L	Istaller RECEIVE		
		V	OCT 2 3 2008		

۲

ų,

-

.

.

BY: OLWR