

MISSISSIPPI DEPARTMENT OF NATURAL RESOURCES

Bureau of Land and Water Resources

Southport Mall

P.O. Box 10631

Jackson, Mississippi 39209

WATER WELL DRILLERS LOG

Breene  
L ~~REDACTED~~  
L1995

70-18 1982 Fry Fogle water well Green  
 date well completed firm name county well located

LANDOWNER: JARVIS

description of formations encountered

from

to

JARVIS DEARMAN  
Luce Dale, MS 39452  
 (mailing address)

Top soil	0	10
Clay	10	20
sand & clay	20	30
Clay	30	50
SAND	50	85

WELL LOCATION:

23 sec 1 T 3 N R 6 E  
4 1/2 miles N of Leakesville  
 (distance) (direction) (nearest town)

WELL PURPOSE: Home  
 (home, irrigation, municipal, industrial)

WELL COMPLETION DATA:

- (1) diameter (inches) 2"
- (2) total depth (feet) 85'
- (3) static water level (feet) \_\_\_\_\_ below  
 top of ground. above
- (4) casing 2" 75'  
 (material) (depth)
- no if telescope see back.  
 (size)
- (5) screen 10 75  
 (length) (depth to top)
- 2" PVC  
 (size) (material)
- (6) pump none 5-w/air  
 (HP) (yield gpm)
- Test air  
 (type power)
- (7) electric log no  
 (yes or no)
- no  
 (organization running log)

(8) how well bottom plugged PVC  
Ball & lock

DRILLERS REMARKS:


DEPT. OF NATURAL RESOURCES  
 BUREAU OF LAND & WATER RESOURCES

FEB - 7 1983

RECEIVED

If well telescopes please sketch and show depths.

GROUND LEVEL

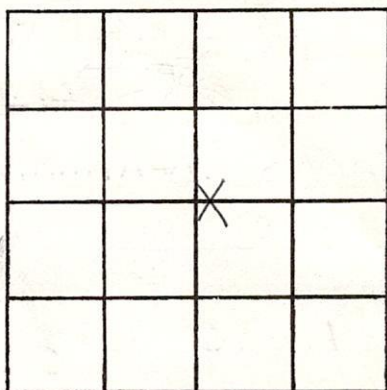

SECTION 23

Please indicate well location X.

ADDITIONAL INFORMATION

If more than one screen,  
show locations of each on sketch.