

MISSISSIPPI DEPARTMENT OF NATURAL RESOURCES

Bureau of Land and Water Resources

Southport Mall

P.O. Box 10631

Jackson, Mississippi 39209

WATER WELL DRILLERS LOG

GREEN
L 1996

3-16-85 1985 2mygale well sew Green  
 date well completed firm name county well located

LANDOWNER: Jawis Diamond

P.O. Drawer 1387  
Leaksville, MS.  
 (mailing address)

WELL LOCATION:

27 sec. 27 T. 30 N. R. 6 E. W  
3 1/2 miles N of Leaksville  
 (distance) (direction) (nearest town)

WELL PURPOSE:

(home, irrigation, municipal, industrial)

WELL COMPLETION DATA:

- (1) diameter (inches) 2"
- (2) total depth (feet) 60'
- (3) static water level (feet) \_\_\_\_\_ below/above top of ground.
- (4) casing PVC, 60',  
 (material) (depth)  
+ if telescope see back.  
 (size)
- (5) screen 5', 55'  
 (length) (depth to top)  
2", PVC  
 (size) (material)
- (6) pump 1, 8  
 (HP) (yield gpm)  
Elect.  
 (type power)
- (7) electric log NO  
 (yes or no)  
WV  
 (organization running log)
- (8) how well bottom plugged PVC  
Ball Check

description of formations encountered	from	to
top soil	0	10
Clay	10	20
Sand	20	25
Clay	25	45
Clay	45	52
Sand	52	60

DRILLERS REMARKS:


RECEIVED

JUN 25 1985

Department of Natural Resources  
 Bureau of Land & Water Resources

If well telescopes please sketch and show depths.

GROUND LEVEL

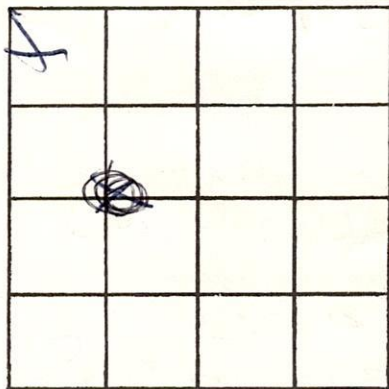

SECTION 27

Please indicate well location X.

ADDITIONAL INFORMATION

If more than one screen,  
show locations of each on sketch.