

MISSISSIPPI DEPARTMENT OF NATURAL RESOURCES

Bureau of Land and Water Resources

Southport Mall

P.O. Box 10631

Jackson, Mississippi 39209

WATER WELL DRILLERS LOG

GREENE  
L 1998  
2018

5-14-86  
date well completed

19 Fryfogle well service  
firm name

Greene  
county well located

LANDOWNER: Hazel Brewer

description of formations encountered

from

to

LEAKSVILLE, MS  
(mailing address)

|           |     |     |
|-----------|-----|-----|
| TOP Soil  | 0   | 10  |
| CLAY      | 10  | 20  |
| SAND      | 20  | 30  |
| HARD CLAY | 30  | 170 |
| SILT SAND | 170 | 180 |
| SAND      | 180 | 190 |

WELL LOCATION:

sec. 29 T 30 N R 6 E S W  
6 miles West of Leaksville  
(distance) (direction) (nearest town)  
on 63 North

WELL PURPOSE:

(home, irrigation, municipal, industrial)

WELL COMPLETION DATA:

- (1) diameter (inches) 2"
- (2) total depth (feet) 190'
- (3) static water level (feet) 80' below top of ground.
- (4) casing PVC, 180' (material) (depth),  
10 (size) if telescope see back.
- (5) screen 10, 180' (length) (depth to top)  
2" PVC (size) (material)
- (6) pump 1, 10 (HP) (yield gpm)  
Elect (type power)
- (7) electric log NO (yes or no)  
NO (organization running log)

(8) how well bottom plugged PVC  
Bail Check

DRILLERS REMARKS:


RECEIVED

JUL 23 1986

Department of Natural Resources  
Bureau of Land & Water Resources

If well telescopes please sketch and show depths.

GROUND LEVEL

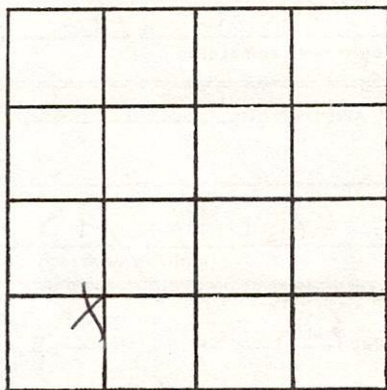

SECTION 29

Please indicate well location X.

ADDITIONAL INFORMATION

If more than one screen,  
show locations of each on sketch.