

MISSISSIPPI DEPARTMENT OF NATURAL RESOURCES

Bureau of Land and Water Resources

Southport Mall

P.O. Box 10631

Jackson, Mississippi 39209

WATER WELL DRILLERS LOG

GREENE
L 1999
2079

6-86 19 Fryfogle well Green
 date well completed firm name county well located

LANDOWNER: Robertson
 Luther Lake
 (by) Lakerville MS
 (mailing address)

description of formations encountered	from	to
TOP Soil	0	10
sand	10	20
sand	20	40
Fine Sand	40	45
Clay	45	120
Sand	120	130

WELL LOCATION:
 sec. 12P T 3N R 6E
 S W
 6 miles N of Lakerville
 (distance) (direction) (nearest town)

WELL PURPOSE:
 (home, irrigation, municipal, industrial)

WELL COMPLETION DATA:

(1) diameter (inches) 2"

(2) total depth (feet) 130'

(3) static water level (feet) 95 below top of ground.

(4) casing PVC, 120, (material), (depth),
 N if telescope see back.
 (size)

(5) screen 10, 120 (length), (depth to top)
 2, PVC (size), (material)

(6) pump 1, 5 (HP), (yield gpm)
 Elect (type power)

(7) electric log NO (yes or no)

(organization running log)

(8) how well bottom plugged PVC
 Ball Check

RECEIVED


SEP 05 1986

Department of Natural Resources
 Bureau of Land & Water Resources

DRILLERS REMARKS:

If well telescopes please
sketch and show depths.

GROUND LEVEL

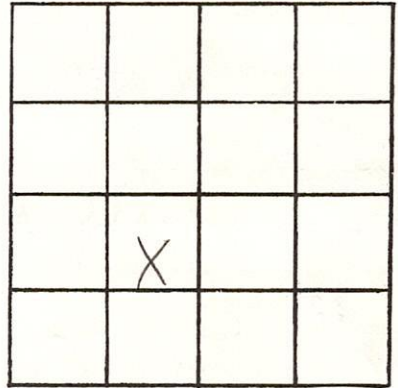

SECTION 28

Please indicate well location X.

ADDITIONAL INFORMATION

If more than one screen,
show locations of each on sketch.