

**GREENE** MISSISSIPPI BOARD OF WATER COMMISSIONERS

M 1 (6)

10-65

**WATER WELL DRILLERS LOG**

Date: Oct, 1965, Driller: Reeples Drilling Co County Greene  
(Name)

(1) Owner of Land:	Description & Color of Materials Sand, Clay, Red Clay, Shell, etc.	Thick- ness Feet	Depth Feet
<u>Guy E. Clark</u> (Name) <u>Seabrook, Miss</u> (Address)	<u>yellow sandy clay</u>	<u>18</u>	<u>18</u>
	<u>Rock</u>	<u>1</u>	<u>19</u>
(2) Location: <u>1/4</u> , <u>1/4</u> , Sec. <u>6</u> T. <u>3<sup>N</sup></u> R. <u>5<sup>W</sup></u>	<u>white clay</u>	<u>19</u>	<u>38</u>
<u>10</u> miles <u>NE</u> of <u>Seabrook</u> (distance) (direction) (Nearest Town)	<u>yellow sand</u>	<u>17</u>	<u>55</u>
(3) Topography: <u>Hilly</u> (Hilly) (Flat) (Level)	<u>yellow clay</u>	<u>29</u>	<u>84</u>
(4) Purpose of Well: <u>Home</u> (Domestic Irrigation Municipal, Industrial, Other)	<u>blue sandy clay</u>	<u>21</u>	<u>105</u>
	<u>blue clay</u>	<u>105</u>	<u>210</u>
	<u>white sand</u>	<u>16</u>	<u>226</u>


Information upon completion of well:

- (1) Diameter 2 inches.
- (2) Total Depth 226 feet.
- (3) Water Level 135 feet below top of ground.
- (4) Cased to 220', Size 2"
- (5) Screen: Size 2", Length 6'
- (6) Were any formations sealed against pollution?  
\_\_\_\_\_ yes, \_\_\_\_\_ no.

If YES depth of formation \_\_\_\_\_

Why \_\_\_\_\_

Drillers Remarks: \_\_\_\_\_

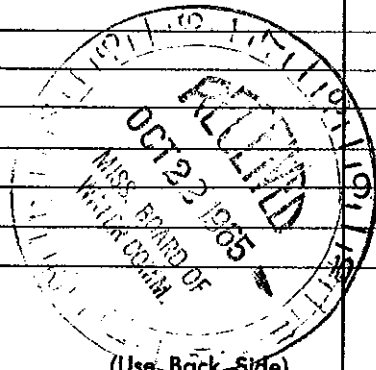

(Use Back Side)

Well No.

Mail this copy to Board of Water Commissioners 429 Miss. St. Jackson, Mis: