

GREENE MISSISSIPPI BOARD OF WATER COMMISSIONERS

N 19

(3)

WATER WELL DRILLERS LOG

8-18-60

Date: 8/18, 1960, Driller: DAVID NEWELL County: PERRY

(Name)

(1) Owner of Land: W.E. ROBERTS
(Name)

MCLAIN, MISS.
(Address)

(2) Location: SE 1/4, SW 1/4, Sec. 29, T. 28, R. 8

_____ miles _____, of MCLAIN
(distance) (direction) (Nearest Town)

(3) Topography: HILLY
(Hilly) (Flat) (Level)

(4) Purpose of Well: DOMESTIC
(Domestic Irrigation, Municipal, Industrial, Other)

Information upon completion of well:

(1) Diameter: 4 1/2 inches.

(2) Total Depth: 189 feet.

(3) Water Level: 0 feet below top of ground.

(4) Cased to: 126, Size: 2 in.

(5) Screen: Size: 0, Length: 0

(6) Were any formations sealed against pollution?


✓ yes, _____ no.

If YES depth of formation: 40 ft

Why: HARD CLAY 40-160

Drillers Remarks:

Description & Color of Materials Sand, Clay, Red Clay, Shell, etc.	Thick- ness Feet	Depth Feet
SAND	0	40
CLAY	40	160
SAND	160	189

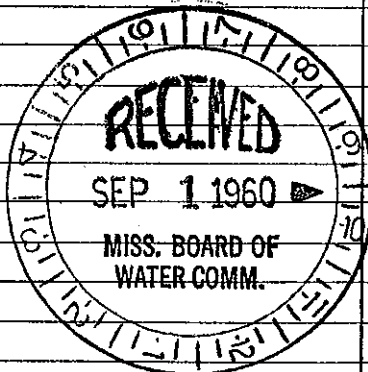

(Use Back Side)

Well No. 7

Mail this copy to Board of Water Commissioners 429 Miss. St. Jackson. Miss.