

GREENE

MISSISSIPPI BOARD OF WATER COMMISSIONERS


N 20 ⑥  
10-15-60

WATER WELL DRILLERS LOG

Greene Co. 7  
~~1300~~

Date: 10/15, 1960, Driller: DAVID NEWELL & SON County: PERRY  
(Name)

(1) Owner of Land:	Description & Color of Materials Sand, Clay, Red Clay, Shell, etc.	Thick- ness Feet	Depth Feet
T. J. LOUIS (Name) McLAIN, MISS. (Address)	STREAKS OF CLAY ALL THE WAY	0-113	
(2) Location: $\frac{1}{4}$ , $\frac{1}{4}$ , Sec. 27 2N 8W T R			
3 miles E of McLain (distance) (direction) (Nearest Town)			
(3) Topography: HILLY (Hilly) (Flat) (Level)			
(4) Purpose of Well: (Domestic Irrigation Municipal, Industrial, Other)			
Information upon completion of well:			
(1) Diameter $4\frac{1}{2}$ inches.			
(2) Total Depth 113 feet.			
(3) Water Level 42 feet below top of ground.			
(4) Cased to 103, Size 2 in			
(5) Screen: Size 2 in, Length 10 ft			
(6) Were any formations sealed against pollution? <input checked="" type="checkbox"/> yes, <input type="checkbox"/> no.			
If YES depth of formation STREAKS OF CLAY all the way Why			
Drillers Remarks:			

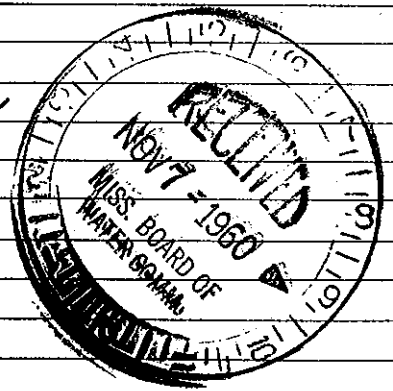

Well No.

(Use Back Side)

Mail this copy to Board of Water Commissioners 429 Miss. St. Jackson, Miss.