

GREENE MISSISSIPPI BOARD OF WATER COMMISSIONERS

N 21 (6)
10-64

WATER WELL DRILLERS LOG

Date: Oct, 1964, Driller: Peoples Drill Co. County: Greene
(Name)

CODED

(1) Owner of Land: <u>Bone M. Leod</u> (Name)	Description & Color of Materials Sand, Clay, Red Clay, Shell, etc.	Thick- ness Feet	Depth Feet
<u>McLean Min</u> (Address) /	<u>White Sand</u>	<u>31</u>	<u>31</u>
(2) Location: <u>1/4, 1/4, Sec. 29 T^{2N} R^{8W}</u> miles _____, of _____ (distance) (direction) (Nearest Town)	<u>Blue shale + lignite streak</u>	<u>24</u>	<u>55</u>
(3) Topography: <u>Flat</u> (Hilly) (Flat) (Level)	<u>Blue shale</u>	<u>92</u>	<u>147</u>
(4) Purpose of Well: <u>Home</u> (Domestic Irrigation Municipal, Industrial, Other)	<u>Blue shale & small sand streak</u>	<u>115</u>	<u>262</u>
	<u>soft blue sandy shale</u>	<u>158</u>	<u>420</u>
	<u>gray humus</u>	<u>90</u>	<u>510</u>
	<u>gray sand</u>	<u>31</u>	<u>541</u>


Information upon completion of well:

- (1) Diameter 2 inches.
- (2) Total Depth 531 feet.
- (3) Water Level 7 low feet below top of ground.
- (4) Cased to 525', Size 2"
- (5) Screen: Size 2", Length 6'
- (6) Were any formations sealed against pollution?
_____ yes, _____ no.

If YES depth of formation _____

Why _____

Drillers Remarks: _____

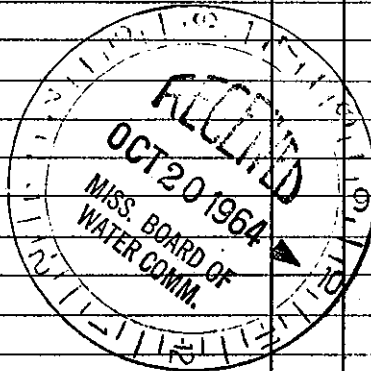

(Use Back Side)

Well No.

Mail this copy to Board of Water Commissioners 429 Miss. St. Jackson, Miss.