Greene	State M	all Depart	
Para	State Well Report Part 1		For Office Use Only:
County: George		t of Environmental Quality	Aquifer:
Permit #:	Office of Land a	nd Water Resources	Well #: N69
Driller Coast Water Well SRV.	P.O. Box 10631 Jackson, MS 39289-0631 (601) 961-5210		L. S. Elevation:
Date drilling completed: 9-11-09			
	(601) 35	4-6938 (fax)	E-log #:
State Law requires that this rep		driller in detail and filed w	ith the Department within
30 days of completion of drilling Well Owner Informa		Well	Location
Owner Name_Steve. Owe		Latitude: 31 . 06,009	" Longitude (28 • 48 • 496
Mailing Address:		C Method of Lat/Long (circle or	
		USGS quad. Hand-held	GPS, Survey-grade GPS
Malain N	1.0	SE SE V So 29	Twn T2H Rng Row
Mc Lain, M City	te Zip Code	<u>JC % JC % Sec_21</u>	
Telephone No. 208 392-41		Distance Direction	Nearest Town of ME CAIN
	Weil I	Data	Fich
Purpose of Well (circle one) Home Ind	lustrial Public Supply	Jata Irrigation Fish Culture	Other: Camp
Date well drilling started: 9-11-0			
If flowing, method of flow regulation: Val			
A 1 1		and surface Date measured:	
Method of Measurement (circle one) st	teel tape electric tape	air line other:	
Hole depth: 180 FT. Well dep	pth: 180 FT.	Well grouted to a depth of	10 feet
Type of grout (circle one): Cement	Bentonite Mix		
Casing length: 170 feet Casin	ng diameter:	inches Type of casing:	PVC
Screen length: 10 feet Scre	en diameter:	inches Type of screen:	PNC
Screen slot size: . OOU inches	Setting depth: From	170 feet to 1	80feet
Type of completion (circle all applicable):	Gravel packed Under	reamed Telescoped Open	hole Natural Development
	Other (describe):		
Top of lap pipe or reduction in casing:	11.	escoped or more than one scre	
Logs run (circle all applicable)! No log run	Electric Gamma Ray	Density Sonic Neutron	Other:
Name of organization running log(s):	NA		
I certify that the well was drilled, constr	ucted, and completed in a	••	• • •
Department of Environmental Quality a	nd/or the Mississippi Dep	partment of Health regulations	s and state laws.
Jack Ridgdell 0-4	72.	Josef	Reddie
Print Name of Water Well Contractor and	License No.	Signature of	
		$-\nu$	
			SEP 1 8 2009

n Ir an ar

~	
BY:	OLWR

N69

Description of Formations Encountered


From To

If well telescopes please sketch below and show depths.



Ground Level	Description of Formations Encountered	11011 10
	TODSOIL	OI
	Mange clay	115
	Under Chick	- Ito
	White coarsesand	
	Blue clay	45 150
	Gray medium Sand	150 180
	pray i contra contra	
	1	
· · ·		

If more than one screen, show location of each on sketch

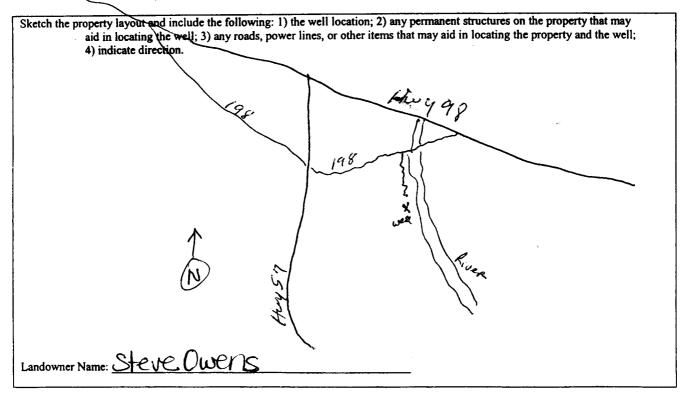

touch Ridgelese

Signature of Water Well Contractor

RECEIVED SEP 1 8 2009 BY: OLWR

Caregoin R	STATE W	ELL REPORT	
Date completed: 9-11-09	Pump Installe Mississippi Departm Office of Lan P.C Jackson (6 (601)	Part 2 pr's Completion Report ment of Environmental Quality d and Water Resources D. Box 10631 MS 39289-0631 01) 961-5210) 354-6938 (fax)	For Office Use Only: Aquifer: 1 6 9 Well #:
installation of pump.	epared by the pump installer in d		ent within 30 days of the
Owner Name: <u>Steve</u> Mailing Address:	. Owens	Latitude: <u>31°C6'CC9</u> " Method of Lat/Long (circle on	Longitude 088°48'496 " we): Conventional Survey,
0.4	un MS State Zip Code	USGS quad, Hand	Held GPS) Survey-grade GPS Twn <u>TAN</u> Rng <u>R8W</u> Nearest Town
Par	тр Туре	Por	wer Type
Ci Air Lift Jet	submersible		ircle one ne Engine Natural Gas
Bucket Pisto Centrifugal Rota		Electric Motor Hand Windmill Other (specify):
Other (specify):			3/4 Н.Р.
Date Pump Installed:	Gallons Per Minute	Setting Depth: <u>30FT.Drc</u> Number of Stages:	
	Test Data		asuring Water Level rcle one
	0 i/ Feet Below Land Surface 10 i/ Feet Below Land Surface	Air Line Electric Meas Other (specify):	
Drawdown [(B) - (A)]:	Feet Below Land Surface	For flowing well, measured sh	1
Test Pumping Rate:7	Gallons Per Minute	Well yielded <u>35</u>	_GPM with a drawdown of hours of pumping
I HEREBY CERTIFY that the Jack Ridget Print Name of Pump Installer as	above statements are true to the bes 110-472 ind License No. (if applicable)	t of my knowledge.	ulflee stater RECEIVI
		\mathcal{O}	OCT 0 9 200

*****• ,

.

BY: OLWR
