
State W	ell Report	
	Driller's Log	
Mississippi Departmer	Aquifer: N 7/	
PO	nd Water Resources Box 2307 Well #:	
Driller Muk + March Jackson	n, MS 39225	
Data duilling annulated: A Contraction of the Contr	901-5210 1 5228 (fax)	
(001)00	E-log #:	
State Law requires that this report be prepared by the lic	ense holder responsible for the work and filed with the	
Department at the above address within 30 days of comp Information on Well Owner	Well or Borehole Location	
(Landowner if borehole is not for a water well)	Latitude: 31 ° 09 , 34 " Longitude: 88° 48, 36 "	
Owner Name Keith Bufkin	Latitude: 5 C 2 2 Longitude: 6 C 2 0 2 C	
	Method of Lat/Long (circle one): Conventional Survey,	
Mailing Address: 12/ White Water KO	USGS quad, Hand-held GPS, Survey-grade GPS	
	SE 1/ 52 1/ Sec 5 TWNT 2N RNg RBW	
Millain Ms 39456 City State Zip Code		
City State Zip Code	Distance Direction Nearest Town 3 // Miles V of M ² Lan	
Telephone No. ()		
Well / Bore	hala Data	
Date drilling started: $\frac{\mathscr{E} \cdot 20/\mathcal{O}}{\mathcal{O}}$ Date drilling completed: $\frac{\mathscr{E} \cdot 20}{\mathcal{O}}$	Hole depth: 58 Hole diameter: 9/2	
Location of the source of any surface water used for drilling: \mathcal{MO}	NZ	
Method of dosing and volume of Chlorine used in drilling and deve	lopment:	
Logs run (circle all applicable): No log run Electric Gamma Ray	Density Sonic Neutron Other:	
Name of organization running log(s):	-	
Purpose of borehole (check one): Water Well Ceotechnical/Geol	ogical Investigation Ground Source Heat Pump	
Seismic Survey Other (<i>describe</i>	2)	
If drilling is not related to water well construction, skip the remainder of this block		
Purpose of Well (check one): Home Industrial Public Supply Irrigation Fish Culture Other:		
If a flowing well, method of flow regulation: Valve Other (describe)		
Static Water Level:feet above or below (circle one) land surface Date measured:		
Method of Measurement (circle one) steel tape electric tape air line other:		
Well depth: 58 Well grouted to a depth of 10 feet Type		
Casing length: <u>53</u> feet Casing diameter: <u>2</u>	A	
Screen length: <u>5</u> feet Screen diameter: <u>2</u>	_inches Type of screen: PUC Unapped_	
Screen slot size:inches Setting depth: From _	53 feet to 58 feet	
Type of completion (circle all applicable): Fravel packed Under	rreamed Telescoped Open hole Natural Development	
Other (describe):		
Top of lap pipe or reduction in casing:feet. If te	lescoped or more than one screen, describe on next page	
L	Form: OLWR-SWR-1A (04/08)	

RECEIVED SEP 2 0 2010 BY: OLWR

The sketch below only required for water wells

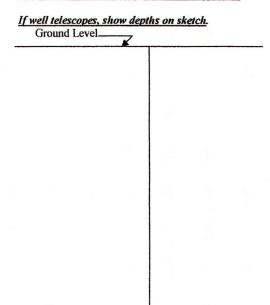


Description of formations encountered must be provided for all wells and boreholes, unless specifically exempted by regulations

NTI

Description of Formations Encountered	From (depth)	To (depth)
2	Ground Level	
clan	0	5
Rand	5	13
Clan .	15	31
safe	31	33
Class	33	38
rand	38	58
		-

If more than one screen, show location of each on sketch

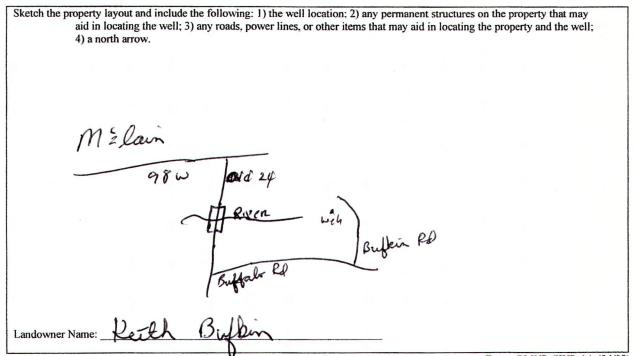

Form: OLWR-SWR-1A (04/08)

I certify that the well/borehole was drilled, constructed, and completed in accordance with all applicable requirements of the Mississippi Department of Environmental Quality and the Mississippi Department of Health regulations, if applicable, and state

laws. 09/10408 8:20-10 Michae [Y] Date

Print Name of Responsible Licensee and License No.

Signature of Licensee

SFP 2 0 2010

2 For Office Use Only: Invironmental Quality Aquifer: // 7/ 309 39225 300 Well #:
Well Location itude: Longitude: hod of Lat/Long (check one): Conventional Survey GS quad Hand-held GPS Main Longitude: Survey-grade GPS
hod of Lat/Long (check one): Conventional Survey GS quad, Hand-held GPSSurvey-grade GPS ¼% Sec5TTZN_R_&&& ance Direction Nearest Town
12 Miles N of M& lain
Power Type
Circle one
el Engine Gasoline Engine Natural Gas
Tric Motor Hand Tractor PTO
dmill Other (specify):
e Power Rating of Motor:
ng Depth:52feet
Method of Measuring Water Level Circle one
Line Electric Measuring Line Steel Tape
lowing well, measured shut in head:feet
yielded GPM with a drawdown of
10 feet after ///2 hours of pumping

• • •

RECEIVED SEP 2 0 2010 BY: OLWR