

# State Well Report

## Part 1

Mississippi Department of Environmental Quality  
Office of Land and Water Resources  
P.O. Box 10631  
Jackson, MS 39289-0631  
(601)961-5210  
(601)354-6938 (fax)

### For Office Use Only:

Aquifer: \_\_\_\_\_  
Well #: Q-24  
L. S. Elevation: \_\_\_\_\_  
E-log #: \_\_\_\_\_

County: Greene  
Permit #: \_\_\_\_\_  
Driller: Michael S. Havard  
Date drilling completed: 8-08-06

**State Law requires that this report be prepared by the driller in detail and filed with the Department within 30 days of completion of drilling of the well.**

Well Owner Information	Well Location
Owner Name: <u>Randy (Bibba) Pierce</u>	Latitude: <u>31° 08' 91"</u> Longitude: <u>88° 39' 11"</u>
Mailing Address: <u>P.O. 1314</u>	Method of Lat/Long (circle one): <u>Conventional Survey</u>
<u>Leakesville MS 39451</u>	USGS quad, Hand-held GPS, Survey-grade GPS
City State Zip Code	<u>NW 1/4 SW 1/4 Sec 12 Twn 22N Rng R7W</u>
Telephone No. <u>(601) 408-1971</u>	Distance Direction Nearest Town
	<u>5 Miles W of Leakesville</u>

### Well Data

Purpose of Well (circle one) Home Industrial Public Supply Irrigation Fish Culture Other: \_\_\_\_\_

Date well drilling started: 8-08-06 Date well drilling completed: 8-08-06

If flowing, method of flow regulation: Valve \_\_\_\_\_ Other (describe) \_\_\_\_\_

Static Water Level: 19 feet above or below (circle one) land surface Date measured: 8-11-06

Method of Measurement (circle one) steel tape electric tape air line other: \_\_\_\_\_

Hole depth: 131 Well depth: 131 Well grouted to a depth of 18 feet

Type of grout (circle one): Cement Bentonite Mix

Casing length: 121 feet Casing diameter: 4 inches Type of casing: PUC 540

Screen length: 10 feet Screen diameter: 4 inches Type of screen: WOP

Screen slot size: .006 inches Setting depth: From 121 feet to 131 feet

Type of completion (circle all applicable): Gravel packed Underreamed Telescoped Open hole Natural Development

Other (describe): \_\_\_\_\_

Top of lap pipe or reduction in casing: \_\_\_\_\_ feet. If telescoped or more than one screen, describe on back of page

Logs run (circle all applicable): No log run Electric Gamma Ray Density Sonic Neutron Other: \_\_\_\_\_

Name of organization running log(s): \_\_\_\_\_

I certify that the well was drilled, constructed, and completed in accordance with all applicable requirements of the Mississippi Department of Environmental Quality and/or the Mississippi Department of Health regulations and state laws.

Michael S. Havard 0-673  
Print Name of Water Well Contractor and License No.

[Signature]  
Signature of Water Well Contractor

RECEIVED  
SEP 01 2006  
BY: OLWR

Q-24


If well telescopes please sketch below and show depths.

Ground Level \_\_\_\_\_

Description of Formations Encountered	From	To
Topsand	0	5
Sand	5	10
Clay	10	18
Sand (coarse)	18	35
Clay	35	39
Sand (coarse)	39	85
Clay	85	88
Sand	88	111
Clay	111	131

If more than one screen, show location of each on sketch

Sketch the property layout and include the following: 1) the well location; 2) any permanent structures on the property that may aid in locating the well; 3) any roads, power lines, or other items that may aid in locating the property and the well; 4) indicate direction.

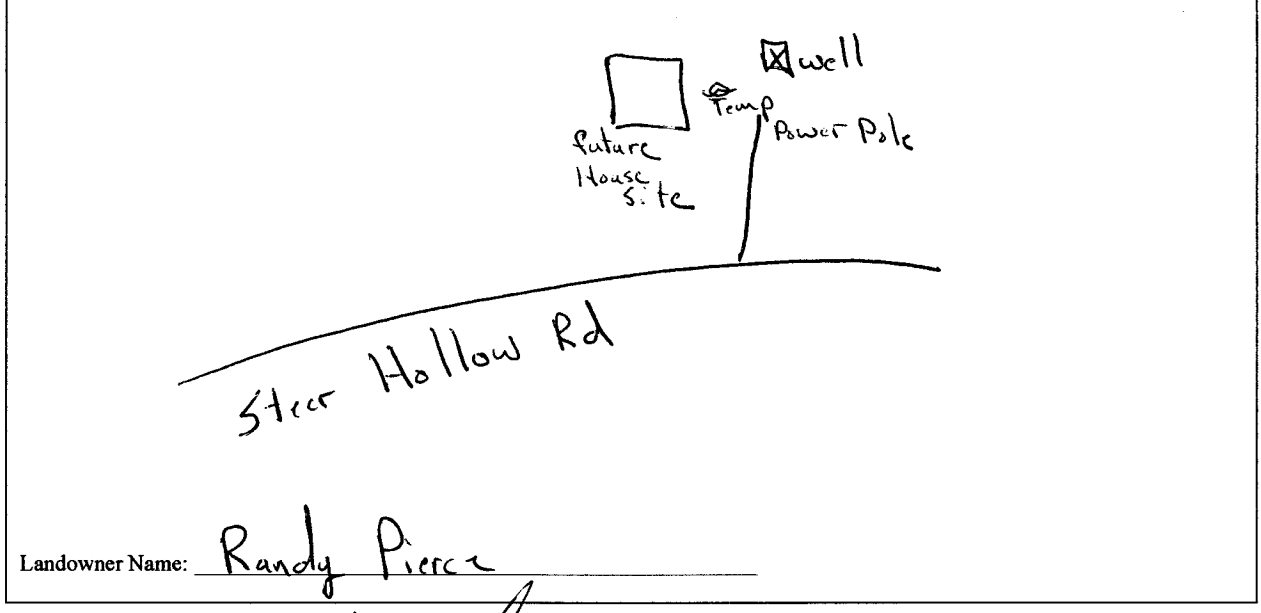

Signature of Water Well Contractor  


RECEIVED  
 SEP 01 2006  
 BY: CLWR

# STATE WELL REPORT

## Part 2

**Pump Installer's Completion Report**  
 Mississippi Department of Environmental Quality  
 Office of Land and Water Resources  
 P.O. Box 10631  
 Jackson, MS 39289-0631  
 (601)961-5210  
 (601)354-6938 (fax)

County: Greene  
 Permit #: \_\_\_\_\_  
 Driller: Michael S. Havard  
 Date completed: 8-11-06

**For Office Use Only:**

Aquifer: \_\_\_\_\_  
 Well #: Q-24  
 Elevation: \_\_\_\_\_

**This report should be prepared by the pump installer in detail and filed with the Department within 30 days of the installation of pump.**

Well Owner Information	Well Location
Owner Name: <u>Randy Pierce</u>	Latitude: <u>N31°08' - 91</u> Longitude: <u>W88°39' 11</u>
Mailing Address: <u>P.O. Box 1314</u>	Method of Lat/Long (circle one): <u>Hand-held GPS</u> Conventional Survey, Survey-grade GPS
<u>Leakesville MS 39451</u>	USGS quad: _____
City State Zip Code	1/4 Sec <u>12</u> Twn <u>T2N</u> Rng <u>R7W</u>
Telephone No. <u>(601) 408-1971</u>	Distance Direction Nearest Town <u>5</u> Miles <u>W</u> of <u>Leakesville</u>

Pump Type Circle one	Power Type Circle one
Air Lift Jet <u>Submersible</u>	Diesel Engine Gasoline Engine Natural Gas
Bucket Piston Turbine	<u>Electric Motor</u> Hand Tractor PTO
Centrifugal Rotary Flowing Well	Windmill Other (specify): _____
Other (specify): _____	Horse Power Rating of Motor: <u>1.5 HP</u>
Date Pump Installed: <u>8-11-06</u>	Setting Depth: <u>90</u> feet
Rated Pump Capacity: <u>27</u> Gallons Per Minute	Number of Stages: <u>10</u>

Pump Test Data	Method of Measuring Water Level Circle one
Date Well Tested: <u>8-11-06</u>	<u>Air Line</u> Electric Measuring Line Steel Tape
Static Water Level (A): <u>19</u> Feet Below Land Surface	Other (specify): _____
Pumping Water Level (B): <u>45</u> Feet Below Land Surface	For flowing well, measured shut in head: _____ feet
Drawdown [(B) - (A)]: <u>26</u> Feet Below Land Surface	Well yielded <u>45</u> GPM with a drawdown of
Test Pumping Rate: <u>45</u> Gallons Per Minute	<u>26</u> feet after <u>4</u> hours of pumping
Duration of Pump Test (minimum 4 hours): <u>4</u> hours	

I HEREBY CERTIFY that the above statements are true to the best of my knowledge.

Michael S. Havard 0-673 \_\_\_\_\_  
 Print Name of Pump Installer and License No. (if applicable) Signature of Pump Installer

RECEIVED  
 SEP 01 2006  
 BY OLWE