
· • •					
. •					
í r	.1	State W	ell Report	For Office Use Only:	
	County: Cleane	Part 1 – D	<b>Friller's Log</b> It of Environmental Quality	Aquifer:	
	Permit #: 0-780	Office of Land ar	nd Water Resources	Well #: 0 33	
	Driller: Joel fier		Box 2307 , MS 39225	L. S. Elevation:	
	Date drilling completed: 10 31-08		961- 5210 1- 5228 (fax)	E-log #:	
L	State Law requires that this repor Department at the above address	t be prepared by the lice	ense holder responsible for t	the work and filed with the or borehole.	
Г	Information on Well C	Owner	Well or Bo	orehole Location	
	(Landowner if borehole is not fo	or a water well)	Latitude: 31 .05 .903	" Longitude <u>33 °37 '319</u> "	
	Owner Name Marson Y UL	il	54 Method of Lat/Long (circle or	19	
	Mailing Address: White Roa	<u>x</u>		GPS, Survey-grade GPS	
		-	SE 1/ QW 1/4 Sec 26	Twn 2N Rng 7W	
	Ceakully us	39555	NE NE 35		
	City Sta	te Zip Code	Distance Direction	of <u>ceature</u> , us	
	Telephone No. ( $601$ ) $344 - 47$				
		Well / Bore		7.	
	Date drilling started: <u>(0-31-08</u> Date dr	illing completed: 10-21	Hole depth:	Hole diameter:	
	Location of the source of any surface water used for drilling:				
	Seismic SurveyOther (describe) If drilling is not related to water well construction, skip the remainder of this block				
	Purpose of Well (check one): Home 🗾				
	If a flowing well, method of flow regulation	on: Valve (	Other (describe)		
	Static Water Level:feet a				
٢٢	Method of Measurement (circle one)				
	Well depth: 250 Well grouted to a d			ment Bentonite Mix	
	Casing length: <u>240</u> feet Cas			Sch 40 Plastin	
	Screen length: <u>10</u> feet Scr	een diameter: <u>2</u>		Sch 40 Plasti	
	Screen slot size: 10inches		feet to		
	Type of completion (circle all applicable)	: Gravel packed Unde	erreamed Telescoped Ope	n hole Natural Development	
		Other (describe):			
	Top of lap pipe or reduction in casing:	feet. If t	elescoped or more than one scr	een, describe on next page	
	L			Form: OLWR-SWR-1A (04/08	

RECEIVED NOV 2 4 2008 BY: OLWR


## The sketch below only required for water wells

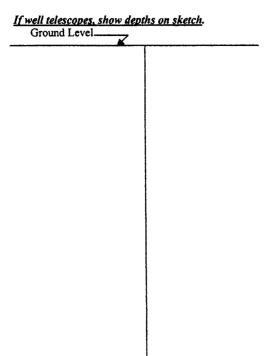

## Description of formations encountered must be provided for all wells and boreholes, unless specifically exempted by regulations

Description of Formations Encountered	From (depth)	To (depth)
	Ground Level	
A A		
Hellow Jon Blue clauz	0	25
<u>A'a</u>		16.4
Thu claiz	25	100
unter Same	101	105
	100	10 5
		1
Spein clan	105	200
0		
Grey gand	200	250
0 0		
		4
	+	
]		
		+
	<u> </u>	_ <u></u>

If more than one screen, show location of each on sketch

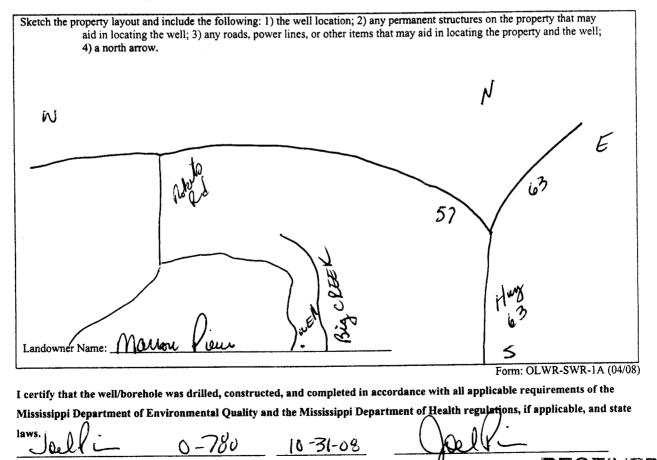

Print Name of Responsible Licensee and License No.

1

Date

Signature of Licensee RECEIVED NOV 2 4 2008

BY: OLWR

	ELL REPORT		
Permit #: 0 - 730 Driller: Oel Vic Pump Installer' Mississippi Departmen Office of Land P.O.	Part 2 s Completion Report nt of Environmental Quality and Water Resources Box 2309 MS 30225 Well # 233		
Date completed: 10-51-55 (601	n, MS 39225 Well 7. [		
Copy information from block on Part 1 This part of the report must be completed by a licensed water well			
report must be attached and both parts filed with the Department of	at the above address within 30 days of well completion. Well Location		
Well Owner Information	Latitude: 31 - 05 - 96 3 Longitude: 88 - 39 - 314		
Mailing Address: Roberts Rood	Method of Lat/Long (check one): Conventional Survey		
Centrulle ms 39555	USGS quad, Hand-held GPS, Survey-grade GPS $5E_{1/2}NW_{1/2}$ Sec_ $26_{T}2N_{R}Tw$		
City State Zip Code			
2411 ~ 777	Distance Direction Nearest Town <u>5</u> Miles <u>ulust</u> of <u>Leakalle</u> , up		
Telephone No. 601 394 - 9777			
Dump Tuna	Power Type		
Pump Type Circle one	Circle one		
Air Lift Jet Submersible	Diesel Engine Gasoline Engine Natural Gas		
Bucket Piston Turbine	Electric Motor Hand Tractor PTO		
Centrifugal Rotary Flowing Well	Windmill Other (specify):		
Other (specify):	Horse Power Rating of Motor:		
Date Pump Installed: 10 - 31 - 08	Setting Depth: 20 Jet line feet		
Rated Pump Capacity:	Number of Stages:		
Pump Test Data	Method of Measuring Water Level Circle one		
Date Well Tested: 10 ~ 3(-08	Steel Tone		
Static Water Level (A):Feet Below Land Surface	Air Line  Electric Measuring Line  Steel Tape    Other (specify):		
Pumping Water Level (B): <u>20</u> Feet Below Land Surface	Other (specify).		
Drawdown [(B) - (A)]:Feet Below Land Surface	For flowing well, measured shut in head:feet		
	Well yielded GPM with a drawdown of		
Test Pumping Rate: 15 Gallons Per Minute	(10)		
Duration of Pump Test (minimum 4 hours): <u>48</u> hours	<u>2</u> feet after <u>48</u> hours of pumping		
Duration of Pump Test (minimum 4 hours): <u>48</u> hours			

•

.

11 11

•

BY: OLWR