

State Well Report

Part 1 - Driller's Log

Mississippi Department of Environmental Quality
Office of Land and Water Resources
P.O. Box 2307
Jackson, MS 39225
(601)961-5210
(601)961-5228 (fax)

County: Greene
Permit #: _____
Driller: Moby & Wash
Date drilling completed: 4-27-09

For Office Use Only:
Aquifer: _____
Well #: Ø 34
L. S. Elevation: _____
E-log #: _____

State Law requires that this report be prepared by the license holder responsible for the work and filed with the Department at the above address within 30 days of completion of drilling of the well or borehole.

| Information on Well Owner (Landowner if borehole is not for a water well) | Well or Borehole Location |
|--|---|
| Owner Name: <u>Wayne Williams</u> | Latitude: <u>31° 10' 08.6"</u> Longitude: <u>88° 39' 11.86"</u> |
| Mailing Address: <u>199 Steer Hollow</u> | Method of Lat/Long (circle one): <u>Hand-held GPS</u> Conventional Survey |
| <u>Leakerville MS 39451</u> | USGS quad, <u>Hand-held GPS</u> Survey-grade GPS |
| City State Zip Code | <u>S1W¼ NW¼ Sec 21 Twn 12N Rng R7W</u> |
| Telephone No. () | Distance <u>5</u> Miles Direction <u>W</u> of Nearest Town <u>Leakerville</u> |

Well / Borehole Data

Date drilling started: 4-27-09 Date drilling completed: 4-27-09 Hole depth: 40 Hole diameter: 4 1/2

Location of the source of any surface water used for drilling: NONE

Method of dosing and volume of Chlorine used in drilling and development: _____

Logs run (circle all applicable): No log run Electric Gamma Ray Density Sonic Neutron Other: _____

Name of organization running log(s): _____

Purpose of borehole (check one): Water Well Geotechnical/Geological Investigation Ground Source Heat Pump
Seismic Survey Other (describe) _____

If drilling is not related to water well construction, skip the remainder of this block

Purpose of Well (check one): Home Industrial Public Supply Irrigation Fish Culture Other: _____

If a flowing well, method of flow regulation: Valve _____ Other (describe) _____

Static Water Level: 18 feet above or below (circle one) land surface Date measured: _____

Method of Measurement (circle one) steel tape electric tape air line other: _____

Well depth: 40 Well grouted to a depth of 10 feet Type of grout (circle one): Neat Cement Bentonite Mix

Casing length: 35 feet Casing diameter: 2 inches Type of casing: PVC 40

Screen length: 5 feet Screen diameter: 2 inches Type of screen: PVC wrapped

Screen slot size: 8 inches Setting depth: From 35 feet to 40 feet

Type of completion (circle all applicable): Gravel packed Underreamed Telescoped Open hole Natural Development
Other (describe): _____

Top of lap pipe or reduction in casing: _____ feet. *If telescoped or more than one screen, describe on next page*

Form: OLWR-SWR-1A (04/08)


RECEIVED
MAY 22 2009
BY: OLWR

34

The sketch below only required for water wells

Description of formations encountered must be provided for all wells and boreholes, unless specifically exempted by regulations

If well telescopes, show depths on sketch.

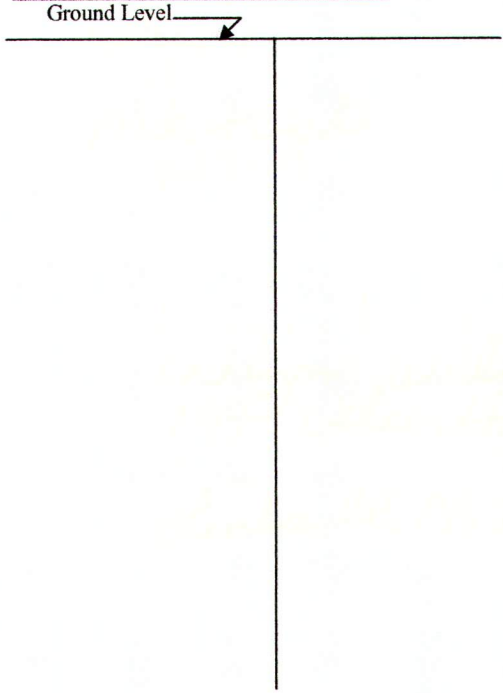

| Description of Formations Encountered | From (depth) | To (depth) |
|---------------------------------------|--------------|------------|
| | Ground Level | |
| clay | 0 | 4 |
| sand | 4 | 20 |
| Clay | 20 | 25 |
| sand | 25 | 40 |
| | | |
| | | |
If more than one screen, show location of each on sketch

Sketch the property layout and include the following: 1) the well location; 2) any permanent structures on the property that may aid in locating the well; 3) any roads, power lines, or other items that may aid in locating the property and the well; 4) a north arrow.

Landowner Name: Wayne Williams

Form: OLWR-SWR-1A (04/08)

I certify that the well/borehole was drilled, constructed, and completed in accordance with all applicable requirements of the Mississippi Department of Environmental Quality and the Mississippi Department of Health regulations, if applicable, and state laws.

Michael R Fryfogel 0408 4-27-09
Print Name of Responsible Licensee and License No. Date

Michael R Fryfogel
Signature of Licensee

RECEIVED
MAY 22 2009
BY: OLWR

STATE WELL REPORT

Part 2

Pump Installer's Completion Report
 Mississippi Department of Environmental Quality
 Office of Land and Water Resources
 P.O. Box 2309
 Jackson, MS 39225
 (601)961-5210
 (601)961-5228 (fax)

County: Greene
 Permit #: _____
 Driller: Mike Hood
 Date completed: 4-29-09
Copy information from block on Part 1

For Office Use Only:

Aquifer: _____
 Well #: Ø34
 Elevation: _____

This part of the report must be completed by a licensed water well contractor or a licensed pump installer. A copy of Part 1 of the report must be attached and both parts filed with the Department at the above address within 30 days of well completion.

| Well Owner Information | Well Location |
|--|---|
| Owner Name: <u>Wayne William</u> | Latitude: <u>30-10-086N</u> Longitude: <u>088-39-118W</u> |
| Mailing Address: <u>199 Steer Hollow</u> | Method of Lat/Long (check one): Conventional Survey _____ |
| <u>Seabrook MS 39451</u> | USGS quad _____, Hand-held GPS <input checked="" type="checkbox"/> , Survey-grade GPS _____ |
| City State Zip Code | _____ ¼ _____ ¼ Sec <u>2</u> T <u>T2N</u> R <u>R7W</u> |
| Telephone No. (____) _____ | Distance Direction Nearest Town |
| | <u>5</u> Miles <u>W</u> of <u>Seabrook</u> |

| Pump Type Circle one | Power Type Circle one |
|---|---|
| Air Lift <input type="checkbox"/> Jet <input checked="" type="checkbox"/> Submersible | Diesel Engine Gasoline Engine Natural Gas |
| Bucket Piston Turbine | <input checked="" type="checkbox"/> Electric Motor Hand Tractor PTO |
| Centrifugal Rotary Flowing Well | Windmill Other (specify): _____ |
| Other (specify): _____ | Horse Power Rating of Motor: <u>1</u> |
| Date Pump Installed: <u>4-29-09</u> | Setting Depth: <u>38</u> feet |
| Rated Pump Capacity: <u>8.12</u> Gallons Per Minute | Number of Stages: <u>2</u> |

| Pump Test Data | Method of Measuring Water Level Circle one |
|--|---|
| Date Well Tested: _____ | <input checked="" type="checkbox"/> Air Line Electric Measuring Line Steel Tape |
| Static Water Level (A): <u>18</u> Feet Below Land Surface | Other (specify): _____ |
| Pumping Water Level (B): <u>28</u> Feet Below Land Surface | For flowing well, measured shut in head: _____ feet |
| Drawdown [(B) - (A)]: <u>10</u> Feet Below Land Surface | Well yielded <u>9</u> GPM with a drawdown of |
| Test Pumping Rate: <u>9</u> Gallons Per Minute | <u>10</u> feet after <u>1 1/2</u> hours of pumping |
| Duration of Pump Test (minimum 4 hours): <u>4</u> hours | |

I HEREBY CERTIFY that the above statements are true to the best of my knowledge.

Michael R Fryfog/c 0408 Michael R Fryfog
 Print Name of Pump Installer and License No. (if applicable) Signature of Pump Installer

Form: OLWR-SWR-1B (04/08)

RECEIVED

MAY 22 2009

BY: OLWR