

Greene
1998
8-4-76

MISSISSIPPI
 BOARD OF WATER COMMISSIONERS
 416 North State Street
 Jackson, Mississippi 39201

WATER WELL DRILLERS LOG

8-4 1976 HHS WELL SER GREENE
 date well completed firm name county well located

2N 7W in SW

LANDOWNER:	description of formations encountered	from	to
<u>MR BYRD</u> <u>LEAKESVILLE</u> MISS (mailing address)	<u>TOP SOIL</u>	<u>1</u>	<u>2</u>
	<u>RED CLAY</u>	<u>2</u>	<u>18</u>
	<u>RED & WHITE CLAY</u>	<u>18</u>	<u>50</u>
	<u>SAND</u>	<u>50</u>	<u>60</u>
WELL LOCATION: sec. <u>10</u> T. <u>2</u> N. <u>2</u> R. <u>7</u> E. <u>8</u> miles <u>SE</u> of <u>LEAKESVILLE</u> (distance) (direction) (nearest town)			
WELL PURPOSE: <u>HOME</u> (home, irrigation, municipal, industrial)			
WELL COMPLETION DATA:			
(1) diameter (inches) <u>2"</u>			
(2) total depth (feet) <u>60</u>			
(3) static water level (feet) <u>40</u> <u>below</u> above top of ground.			
(4) casing <u>PLASTIC</u> , <u>55</u> (material), (depth)			
_____ if telescope see back. (size)			
(5) screen <u>5'</u> , <u>55</u> (length) (depth to top)			
<u>2"</u> , <u>PLASTIC</u> (size) (material)			
(6) pump <u>1</u> , <u>8</u> (HP) (yield gpm)			
<u>ELECTRIC</u> (type power)			
(7) electric log <u>no</u> (yes or no)			
_____ (organization running log)			
(8) how well bottom plugged <u>BACK</u> <u>WASH VALVE</u>			
DRILLERS REMARKS:			

RECEIVED
 APR 11 1977


MISS. BD. OF WATER COMM

RECEIVED
 SEP 30 1976

MISS. BD. OF WATER COMM

If well telescopes please sketch and show depths.

GROUND LEVEL

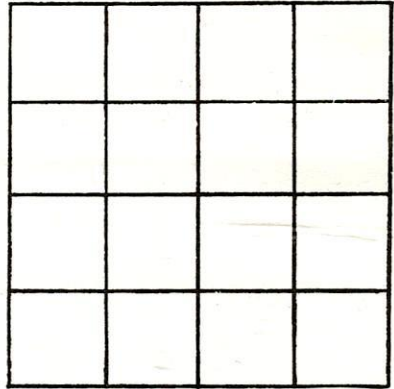

SECTION _____

Please indicate well location X.

ADDITIONAL INFORMATION

If more than one screen, show locations of each on sketch.