

Greene  
1977  
8-14-76

MISSISSIPPI  
 BOARD OF WATER COMMISSIONERS  
 416 North State Street  
 Jackson, Mississippi 39201  
**WATER WELL DRILLERS LOG**

8-14-76 <sup>13P</sup> HDS WELL SER GREENE  
 date well completed firm name county well located

EN 7w is west

LANDOWNER:	description of formations encountered	from	to
<u>LONNIE SPEARS</u>	<u>TOP SOIL</u>	<u>1</u>	<u>2</u>
<u>LEAKESVILLE MISS</u> (mailing address)	<u>RED CLAY</u>	<u>2</u>	<u>15</u>
	<u>SAND</u>	<u>15</u>	<u>30</u>
<b>WELL LOCATION:</b>			
sec. <u>10</u> T. <u>20</u> N. R. <u>7</u> E. <u>8</u> miles <u>W</u> of <u>LEAKESVILLE</u> (distance) (direction) (nearest town)			
<b>WELL PURPOSE:</b> <u>HOME</u> (home, irrigation, municipal, industrial)			
<b>WELL COMPLETION DATA:</b>			
(1) diameter (inches) <u>2"</u>			
(2) total depth (feet) <u>30'</u>			
(3) static water level (feet) <u>15</u> <sup>below</sup> <del>above</del> top of ground.			
(4) casing <u>PLASTIC</u> , <u>25'</u> (material) (depth)			
<u>        </u> if telescope see back. (size)			
(5) screen <u>5'</u> , <u>25</u> (length) (depth to top)			
<u>2"</u> , <u>PLASTIC</u> (size) (material)			
(6) pump <u>1</u> , <u>12</u> (HP) (yield gpm)			
<u>ELECTRIC</u> (type power)			
(7) electric log <u>NO</u> (yes or no)			
<u>        </u> (organization running log)			
(8) how well bottom plugged <u>BACK</u> <u>WASH VALVE</u>			
<b>DRILLERS REMARKS:</b>			

RECEIVED

APR 11 1977

MISS. BD. OF WATER COMM


RECEIVED

SEP 30 1976

MISS. BD. OF WATER COMM

If well telescopes please sketch and show depths.

GROUND LEVEL

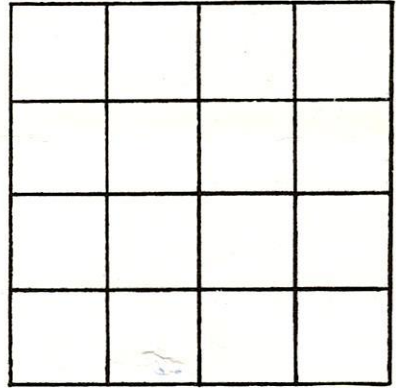

SECTION \_\_\_\_\_

Please indicate well location X.

ADDITIONAL INFORMATION

If more than one screen, show locations of each on sketch.