

Greene MISSISSIPPI BOARD OF WATER COMMISSIONERS

P 13  
10-65 02453 WATER WELL DRILLERS LOG


Date: 10/11, 19 65, Driller: C.P. Clark County Jones  
(Name)

(1) Owner of Land: Town of Leakeville  
(Name)  
Leakeville Miss.  
(Address)  
(2) Location: 1/4, 1/4, Sec. 13 T2N R6W  
(distance) miles (direction) of (Nearest Town)  
(3) Topography: (Hilly) (Flat) (Level)  
(4) Purpose of Well: Municipal  
(Domestic Irrigation  
Municipal, Industrial, Other)

Description & Color of Materials Sand, Clay, Red Clay, Shell, etc.	Thick- ness Feet	Depth Feet
0-8 Clay	8	
8-26 Sand	18	
26-58 blue Clay	32	
58-90 grey Sand	32	
90-98 blue Sand	08	
98-100 Clay	02	
100-112 Blue Sand	12	
112-125 Blue Clay	13	
125-135 Grey Sand	10	
135-189 Clay	54	
189-205 Sand Clay	16	
205-216 Green Clay	11	
216-240 Green Sand	24	

Information upon completion of well:

(1) Diameter 6 inches.  
(2) Total Depth 240 feet.  
(3) Water Level Flowing feet below top of ground.  
(4) Cased to 216, Size 6 in  
(5) Screen: Size 4, Length 24  
(6) Were any formations sealed against pollution?  
yes, no  
If YES depth of formation Cemented Casing  
Why  
Drillers Remarks: Well developed  
with air having a  
Capacity of 2000 P.M.

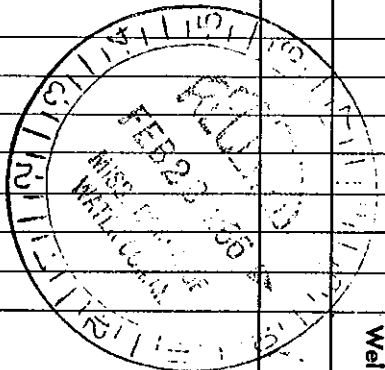

(Use Back Side)

Well No.

Mail this copy to Board of Water Commissioners 429 Miss. St. Jackson, Miss