1	State Well	-	For Office Use Only:
County: Greene	Bart Department of I		Aquifer:
Permit #:	Office of Land and V		Well #: P-79
Driller: Micheal S. Havard	P.O. Box		
	Jackson, MS 39		Li or Lie ruitein
Date drilling completed: 06-16-07	(601)961-		E log #
	(601)354-69	58 (lax)	E-log #:
State Law requires that this repo 30 days of completion of drilling			
Well Owner Information		Well	Location
Owner Name Chris Ducitt		itude: <u>31 ° 67 '62</u>	" Longitude: 88 ° 32 ' 91
Mailing Address: P.O. Box 168		thod of Lat/Long (circle or	e): Conventional Survey, 3 9
		USGS quad, Hand-held	GPS, Survey-grade GPS
1 1 11	N	E 1/4 NW 1/4 Sec_13	Twn T2N Rng RUN
Leakesville MS	<u>394/51</u> Zip Code Dis	stance Direction	Nearest Town
5,	Zip Code Dis	3 Miles $3$	of Leakesville
elephone No. ( <u>COI) 394-8988</u>			
	Well Data		
Indu	strial Dublic Supely Ind	ration Fish Culture	Other:
ate well drilling started:			
flowing, method of flow regulation: Valv	e Other (descri	be)	
tatic Water Level: + 2 feet abo	voor below (circle one) land s	surface Date measured:_	06-16-07
lethod of Measurement (circle one)	el tape electric tape	air line other:	
ole depth: 103 Well dept	h: 103 W	ell grouted to a depth of	12feet
ype of grout (circle one): Cement	Bentonite Mix		
asing length: <u>93</u> feet Casing		thes Type of casing	SHO PUR RE
creen length: <u>\O</u> feet Scree			
ereen slot size: <u>.OD4</u> inches		(4)	
ype of completion (circle all applicable):	Gravel packed Underream	ed Telescoped Open	hole Natural Development
	Other (describe):		· · · · · · · · · · · · · · · · · · ·
op of lap pipe or reduction in casing:	feet. If telesco	ped or more than one scr	een, describe on back of page
ogs run (circle all applicable): No log run	Electric Gamma Ray De	ensity Sonic Neutron	Other:
ame of organization running log(s):			
certify that the well was drilled, constru			
epartment of Environmental Quality ar	d/or the Mississippi Departr	nent of Health regulation	s and state laws.
Michael S Harrad	0-673	71-11	. Ad
	- I MAN	// - /	
rint Name of Water Well Contractor and L	icense No.	Signature of	Water Well Contractor

AUG 1.3 2007 BY: OLWR


P- 79

If well telescopes please sketch below and show depths.

Ground Level

Description of Formations Encountered	From	То
Top-sand	0	8
Class	\$	35
Sand + Clay_	35	75
Sand / W Lighin	75	87
Sand	87	103
		_

If more than one screen, show location of each on sketch

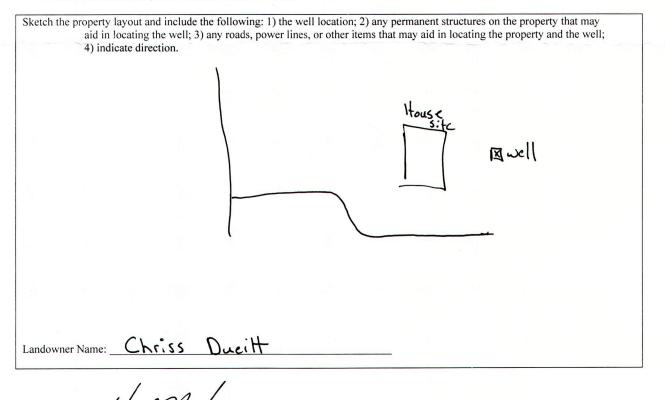

Signature of Water Well Contractor

AUG 1 3 2007 BY: OLWR

STATE W	ELL REPORT		
County: <u>Greene</u> Permit #: Driller: <u>Michael S. Havard</u> Date completed: O(-12:07) Pump Installer Mississippi Departme Office of Land P.O. Jackson, (601)	Part 2    For Office Use Only:      's Completion Report    Aquifer:      nt of Environmental Quality    Aquifer:      Box 10631    Well #:      MS 39289-0631    Well #:      )961-5210    Elevation:		
This report should be prepared by the pump installer in det installation of pump.			
Well Owner Information	Well Location		
Owner Name: Chris Dueitt	Latitude: <u>N31°07.62</u> Longitude: <u>N8°32.91</u>		
Mailing Address: P.O. 168	Method of Lat/Long (circle one): Conventional Survey,		
	USGS quad, Hand-held GPS Survey-grade GPS		
<u>Leakesuille MS 39451</u> City State Zip Code	1/4 1/4 Sec 13 Twn T2N Rng Ruw		
City State Zip Code	Distance Direction Nearest Town		
Telephone No. (601) 394-8988	<u>3</u> Miles <u>5</u> of <u>Leakesville</u>		
D	Power Type		
Pump Type Circle one	Circle one		
Air Lift Submersible	Diesel Engine Gasoline Engine Natural Gas		
Bucket Piston Turbine	Hand Tractor PTO		
Centrifugal Rotary Flowing Well	Windmill Other (specify):		
Other (specify):	Horse Power Rating of Motor:		
Date Pump Installed: 06 - 17 - 07	Setting Depth:55feet		
Rated Pump Capacity: 10 Gallons Per Minute	Number of Stages: 2		
Pump Test Data	Method of Measuring Water Level Circle one		
Date Well Tested: 04 - 17 - 07			
Static Water Level (A): <b>+ 2</b> Feet Below Land Surface	Air Line  Electric Measuring Line  Steel Tape    Other (specify):		
Pumping Water Level (B): <u>10</u> Feet Below Land Surface	(speen)		
Drawdown $[(B) - (A)]$ : Feet Below Land Surface	For flowing well, measured shut in head:feet		
Test Pumping Rate:Gallons Per Minute	Well yieldedGPM with a drawdown of		
Duration of Pump Test (minimum 4 hours): $\underline{\boldsymbol{\mathcal{U}}}_{\text{hours}}$	hours of pumping		
I HEREBY CERTIFY that the above statements are true to the best	of my knowledge.		
Michael S. Havard O-673 Minhould Hod			
Print Name of Pump Installer and License No. (if applicable)	Signature of Pump Installer		

Michael S. Havard O- C7 3 Print Name of Pump Installer and License No. (if applicable)

RECEIVED AUG 1 3 2007 BY: OLWR