

County: Greene  
 Permit #: \_\_\_\_\_  
 Driller: Michael S Howard  
 Date drilling completed: 10-25-07

**State Well Report**  
**Part 1 – Driller’s Log**

Mississippi Department of Environmental Quality  
 Office of Land and Water Resources  
 P.O. Box 10631  
 Jackson, MS 39289-0631  
 (601)961-5210  
 (601)354-6938 (fax)

**For Office Use Only:**  
 Aquifer: \_\_\_\_\_  
 Well #: P-80  
 L. S. Elevation: \_\_\_\_\_  
 E-log #: \_\_\_\_\_

*State Law requires that this report be prepared by the license holder responsible for the work and filed with the Department at the above address within 30 days of completion of drilling of the well or borehole.*

Information on Well Owner (Landowner if borehole is not for a water well)	Well or Borehole Location
Owner Name: <u>Ron Edwards</u>	Latitude: <u>31° 06' 841"</u> Longitude: <u>88° 36' 125"</u>
Mailing Address: <u>2918 Hwy 26-E</u>	Method of Lat/Long (circle one): <u>Hand-held GPS</u> Conventional Survey, <u>42</u>
<u>Wiggins MS 39577</u>	USGS quad: <u>Hand-held GPS</u> Survey-grade GPS
City State Zip Code	<u>NW</u> ¼ <u>NE</u> ¼ Sec <u>29</u> ✓ Twn <u>T2N</u> Rng <u>R6W</u>
Telephone No. <u>(601) 928-5274</u>	Distance Direction Nearest Town <u>3</u> Miles <u>SW</u> of <u>Lakesville</u>

**Well / Borehole Data**

Date drilling started: 10-25-07 Date drilling completed: 10-25-07 Hole depth: 108 Hole diameter: 8"

Location of the source of any surface water used for drilling: \_\_\_\_\_  
 Method of dosing and volume of Chlorine used in drilling and development: \_\_\_\_\_

Logs run (circle all applicable): No log run Electric Gamma Ray Density Sonic Neutron Other: \_\_\_\_\_  
 Name of organization running log(s): \_\_\_\_\_

Purpose of borehole (check one): Water Well  Geotechnical/Geological Investigation \_\_\_\_\_ Ground Source Heat Pump \_\_\_\_\_  
 Seismic Survey \_\_\_\_\_ Other (describe) \_\_\_\_\_

***If drilling is not related to water well construction, skip the remainder of this block***

---

Purpose of Well (check one): Home  Industrial \_\_\_\_\_ Public Supply \_\_\_\_\_ Irrigation \_\_\_\_\_ Fish Culture \_\_\_\_\_ Other: \_\_\_\_\_

If a flowing well, method of flow regulation: Valve \_\_\_\_\_ Other (describe) \_\_\_\_\_

Static Water Level: 55 feet above or below (circle one) land surface Date measured: 10-11-06-07

Method of Measurement (circle one) steel tape electric tape air line other: \_\_\_\_\_

Well depth: 108 Well grouted to a depth of 12 feet Type of grout (circle one): Neat Cement Bentonite Mix

Casing length: 98 feet Casing diameter: 4 inches Type of casing: PVC 540 BE

Screen length: 10 feet Screen diameter: 4 inches Type of screen: WOP PVC

Screen slot size: .006 inches Setting depth: From 98 feet to 108 feet

Type of completion (circle all applicable): Gravel packed Underreamed Telescoped Open hole Natural Development  
 Other (describe): \_\_\_\_\_


Top of lap pipe or reduction in casing: \_\_\_\_\_ feet. ***If telescoped or more than one screen, describe on next page***

Form: OLWR-SWR-1A

**RECEIVED**  
**DEC 13 2007**  
**BY: OLWR**

The sketch below only required for water wells

If well telescopes, show depths on sketch.

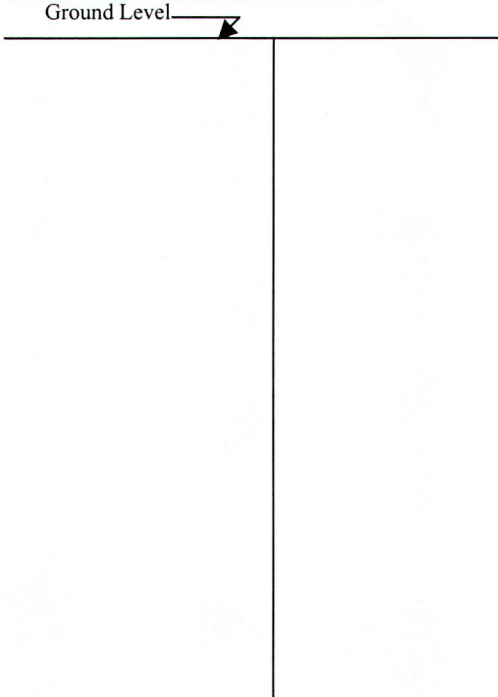

Description of formations encountered must be provided for all wells and boreholes, unless specifically exempted by regulations

Description of Formations Encountered	From (depth)	To (depth)
Topsand	Ground Level	6
Clay yellow	6	12
Clay Blue	12	53
Silt	53	62
Silt/sand streaks	62	70
Clay	70	71
Silt	71	76
Sand, fine-med	76	84
Clay	84	96
Sand (med)	96	108

If more than one screen, show location of each on sketch

Sketch the property layout and include the following: 1) the well location; 2) any permanent structures on the property that may aid in locating the well; 3) any roads, power lines, or other items that may aid in locating the property and the well; 4) a north arrow.

Landowner Name: Ron Edwards

Form: OLWR-SWR-1A

I certify that the well/borehole was drilled, constructed, and completed in accordance with all applicable requirements of the Mississippi Department of Environmental Quality and the Mississippi Department of Health regulations, if applicable, and state laws.

Michael S. Havard 0-673 11-23-07  
 Print Name of Responsible Licensee and License No.      Date

[Signature]  
 Signature of Licensee

**RECEIVED**  
**DEC 03 2007**  
**BY: OLWR**

# STATE WELL REPORT

## Part 2

**Pump Installer's Completion Report**  
 Mississippi Department of Environmental Quality  
 Office of Land and Water Resources  
 P.O. Box 10631  
 Jackson, MS 39289-0631  
 (601)961-5210  
 (601)354-6938 (fax)

County: Greene  
 Permit #: \_\_\_\_\_  
 Driller: Michaels Howard  
 Date completed: 11-06-07  
*Copy information from block on Part 1*

**For Office Use Only:**

Aquifer: \_\_\_\_\_  
 Well #: P-80  
 Elevation: \_\_\_\_\_

*This part of the report must be completed by a licensed water well contractor or a licensed pump installer. A copy of Part 1 of the report must be attached and both parts filed with the Department at the above address within 30 days of well completion.*

Well Owner Information	Well Location
Owner Name: <u>Ron Edwards</u>	Latitude: <u>N31°06.841</u> Longitude: <u>W88°36.1785</u>
Mailing Address: <u>2918 Hwy 26-E</u>	Method of Lat/Long (check one): Conventional Survey _____, USGS quad _____, Hand-held GPS <input checked="" type="checkbox"/> , Survey-grade GPS _____
<u>Higgins MS 39597</u> City State Zip Code	_____ ¼ _____ ¼ Sec <u>29</u> T <u>2N</u> R <u>6W</u>
Telephone No. <u>(601) 928-5274</u>	Distance Direction Nearest Town <u>3</u> Miles <u>SW</u> of <u>Lakesville</u>

Pump Type Circle one	Power Type Circle one
Air Lift Jet <input type="checkbox"/> <u>Submersible</u>	Diesel Engine Gasoline Engine Natural Gas
Bucket Piston Turbine	<u>Electric Motor</u> Hand Tractor PTO
Centrifugal Rotary Flowing Well	Windmill Other (specify): _____
Other (specify): _____	Horse Power Rating of Motor: <u>1</u>
Date Pump Installed: <u>11-06-07</u>	Setting Depth: <u>103</u> feet
Rated Pump Capacity: <u>19</u> Gallons Per Minute	Number of Stages: <u>8</u>

Pump Test Data	Method of Measuring Water Level Circle one
Date Well Tested: <u>11-06-07</u>	Air Line <input type="checkbox"/> <u>Electric Measuring Line</u> Steel Tape
Static Water Level (A): <u>55</u> Feet Below Land Surface	Other (specify): _____
Pumping Water Level (B): <u>93</u> Feet Below Land Surface	For flowing well, measured shut in head: _____ feet
Drawdown [(B) - (A)]: <u>38</u> Feet Below Land Surface	Well yielded <u>12</u> GPM with a drawdown of
Test Pumping Rate: <u>12</u> Gallons Per Minute	<u>38</u> feet after <u>4</u> hours of pumping
Duration of Pump Test (minimum 4 hours): _____ hours	

I HEREBY CERTIFY that the above statements are true to the best of my knowledge.

Michaels Howard 0-673 [Signature]  
 Print Name of Pump Installer and License No. (if applicable) Signature of Pump Installer

RECEIVED  
 DEC 03 2007  
 BY: OLWR