

C. P. CLARK  
WATER WELL DRILLING

ROUTE 2

MISSISSIPPI LAUREL, MISS. 39440  
BOARD OF WATER COMMISSIONERS  
416 North State Street  
Jackson, Mississippi 39201

WATER WELL DRILLERS LOG

Greene  
Q 6  
1-16-69

1/16 1969  
date well completed

C. P. Clark  
firm name

Greene  
county well located

LANDOWNER: Greenville  
Colored School  
Leaksville Miss  
(mailing address)

WELL LOCATION:  
sec. 7 T. 20 N. R. 5 E.  
1 miles East of Leaksville  
(distance) (direction) (nearest town)

WELL PURPOSE: School  
(home, irrigation, municipal, industrial)

description of formations encountered	from	to
Surface Sand	0	17
Blue Clay	17	50
Sandy Clay	50	60
Clay	60	78
sandy clay	78	81
fine sand	81	101
Clay	101	109
fine sand	109	180
medium sand	180	213

WELL COMPLETION DATA:

(1) diameter (inches) 4

(2) total depth (feet) 213

(3) static water level (feet) 0+5 below above top of ground.

(4) casing Galv. Iron 128  
(material) (depth)  
2 3/8 if telescope see back.  
(size)

(5) screen 25 188  
(length) (depth to top)  
2 3/8 in S.S.  
(size) (material)

(6) pump 5 75  
(HP) (yield gpm)  
3 Brass 2 20V  
(type power)

(7) electric log NO  
(yes or no)

(organization running log)

JAN 21 1969


If well telescopes please sketch and show depths.

GROUND LEVEL

4" Casing 128 ft

4x2 Lead Seal at 122

6" S.S. Screen #006 steel  
6" S.S. Pipe

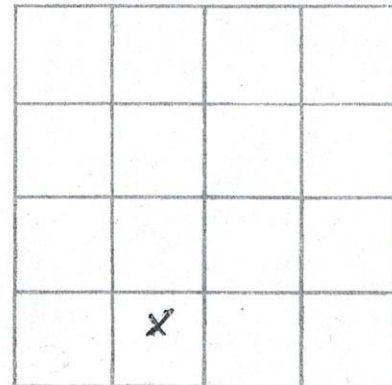

SECTION 7

Please indicate well location X.

ADDITIONAL INFORMATION

Well closed at the  
date of 15<sup>th</sup> P.M.  
Total drawdown  
Pumping @ 750 P.M.  
was 11.6 ft