

GREENE
Q 27

MISSISSIPPI DEPARTMENT OF NATURAL RESOURCES
Bureau of Land and Water Resources
Southport Mall
P.O. Box 10631
Jackson, Mississippi 39209
WATER WELL DRILLERS LOG

CODED

6-86 19 Fryfogle Well Green
date well completed firm name county well located

LANDOWNER: M.W. Hicks

Pt 5, Bx 239
Lucedale, MS
(mailing address)


description of formations encountered	from	to
TOP SOIL	0	5
Clay	5	20
sand	20	38
Streaks Sand + Cl	38	45
Sandy clay	45	60
Sand - Med. Coar	60	110

WELL LOCATION:
35 4 sec. 4 T 2 N S R 5 E W
5 1/2 miles SE of Leakesville
(distance) (direction) (nearest town)

WELL PURPOSE:
(home, irrigation, municipal, industrial)

WELL COMPLETION DATA:

- (1) diameter (inches) 4"
- (2) total depth (feet) 110'
- (3) static water level (feet) 60' below top of ground.
- (4) casing PVC 90 (material), 4" (depth), 4" (size) If telescope see back.
- (5) screen 20 90 (length), 4 (depth to top), 4 (size), PVC (material)
- (6) pump 5 (HP), 100 (yield gpm), Cld. (type power)
- (7) electric log N (yes or no), N (organization running log)
- (8) how well bottom plugged PVC Ball check

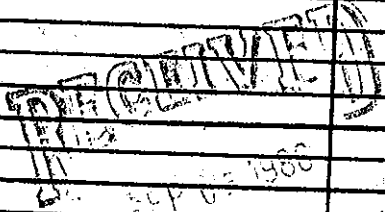

Department of Natural Resources
Bureau of Land & Water Resources

DRILLERS REMARKS: