




If well telescopes please sketch and show depths.

GROUND LEVEL

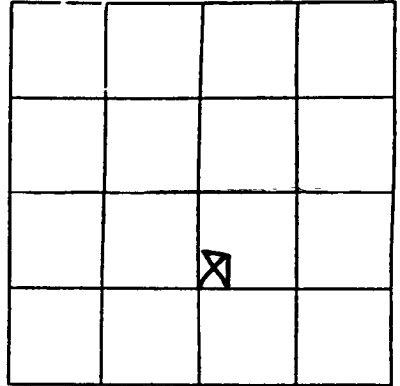

SECTION 25

Please indicate well location X.

Pump Capacity (GPM)	No. of Stages	Setting Depth
<u>19</u>	<u>9</u>	<u>130</u> FT.
PUMP TEST		
Well yielded <u>27</u> GPM with		
a drawdown of <u>12</u> ft.		
after <u>1.5</u> hours of pumping		

LOG DATA

TYPE OF LOG RUN (Circle One): No Log Run  
 Electric, Gamma Ray, Density, Sonic, Neutron, Other (Describe) \_\_\_\_\_

Name of Organization Running Log \_\_\_\_\_

GEOLOGIC DATA (Office Use Only)

Surface Elev.	Geologic Unit	Unit Thickness	Depth to Top
Subs. SWL	Date	Analysis	Aquifer Test

Driller's Remarks

\* \_\_\_\_\_  
 \_\_\_\_\_  
 \_\_\_\_\_  
 \_\_\_\_\_  
 \_\_\_\_\_

If more than one screen, show location of each on sketch.