

County: Greene  
 Permit #: 0-780  
 Driller: J Paul  
 Date drilling completed: 6-28-17

### State Well Report

#### Part 1 - Driller's Log

Mississippi Department of Environmental Quality  
 Office of Land and Water Resources  
 P.O. Box 2309  
 Jackson, MS 39225  
 (601)961- 5210  
 (601)961- 5228 (fax)

For Office Use Only:  
 Aquifer: \_\_\_\_\_  
 Well #: Q 49  
 L. S. Elevation: \_\_\_\_\_  
 E-log #: \_\_\_\_\_

**State Law requires that this report be prepared by the license holder responsible for the work and filed with the Department at the above address within 30 days of completion of drilling of the well or borehole.**

Information on Well Owner (Landowner if borehole is not for a water well)	Well or Borehole Location
Owner Name: <u>William Hoag</u>	Latitude: <u>31° 6' 7"</u> Longitude: <u>88° 26' 3"</u>
Mailing Address: <u>213 594 Rd</u>	Method of Lat/Long (circle one): <u>Conventional Survey</u>
City: <u>Leaksville MS</u> State: <u>MS</u> Zip Code: <u>39555</u>	USGS quad, Hand-held GPS, Survey-grade GPS
Telephone No. <u>(601) 394-8587</u>	<u>NE 1/4 SE 1/4 Sec 36 Twn 2N Rng 5W</u>
	Distance: <u>10</u> Miles Direction: <u>NE</u> of Nearest Town: <u>Rocky Creek, MS</u>

**Well / Borehole Data**

Date drilling started: 6-27-17 Date drilling completed: 6-28-17 Hole depth: 113 Hole diameter: 4 inches

Location of the source of any surface water used for drilling: Aquifer, MS  
 Method of dosing and volume of Chlorine used in drilling and development: 2000 water 5 gal bleach

Logs run (circle all applicable): No log run Electric Gamma Ray Density Sonic Neutron Other: \_\_\_\_\_  
 Name of organization running log(s): \_\_\_\_\_

Purpose of borehole (check one): Water Well  Geotechnical/Geological Investigation \_\_\_\_\_ Ground Source Heat Pump \_\_\_\_\_  
 Seismic Survey \_\_\_\_\_ Other (describe) \_\_\_\_\_

*If drilling is not related to water well construction, skip the remainder of this block* **RECEIVED**

Purpose of Well (check one): Home  Industrial \_\_\_\_\_ Public Supply \_\_\_\_\_ Irrigation \_\_\_\_\_ Fish Culture \_\_\_\_\_ Other: \_\_\_\_\_ **JUL 19 2017**

If a flowing well, method of flow regulation: Valve \_\_\_\_\_ Other (describe) \_\_\_\_\_

Static Water Level: 2 feet above or below (circle one) land surface Date measured: 6-28-17 WWR

Method of Measurement (circle one) steel tape electric tape air line other: \_\_\_\_\_

Well depth: 113 Well grouted to a depth of 10 feet Type of grout (circle one): Neat Cement Bentonite Mix

Casing length: 103 feet Casing diameter: 4 inches Type of casing: Plastic

Screen length: 10 feet Screen diameter: 4 inches Type of screen: Plastic

Screen slot size: 10 inches Setting depth: From 103 feet to 113 feet

Type of completion (circle all applicable): Gravel packed Underreamed Telescoped Open hole Natural Development  
 Other (describe): \_\_\_\_\_

Top of lap pipe or reduction in casing: \_\_\_\_\_ feet. If telescoped or more than one screen, describe on next page

# STATE WELL REPORT

## Part 2

**Pump Installer's Completion Report**  
 Mississippi Department of Environmental Quality  
 Office of Land and Water Resources  
 P.O. Box 2309  
 Jackson, MS 39225  
 (601)961-5210  
 (601)961-5228 (fax)

County: Greene  
 Permit #: 0-780  
 Driller: J Pierce  
 Date completed: 6-28  
*Copy information from block on Part 1*

**For Office Use Only:**

Aquifer: \_\_\_\_\_  
 Well #: Q49  
 Elevation: \_\_\_\_\_

*This part of the report must be completed by a licensed water well contractor or a licensed pump installer. A copy of Part 1 of the report must be attached and both parts filed with the Department at the above address within 30 days of well completion.*

Well Owner Information	Well Location
Owner Name: <u>William Herring</u>	Latitude: <u>31-6-7</u> Longitude: <u>88-26-3</u>
Mailing Address: <u>213 Hwy 594</u>	Method of Lat/Long (check one): Conventional Survey <input type="checkbox"/> <sup>29</sup>
<u>Cooksville, MS 39452</u>	USGS quad _____, Hand-held GPS <input checked="" type="checkbox"/> Survey-grade GPS <input type="checkbox"/>
City State Zip Code	<u>NE 1/4 SE 1/4 Sec 36 T 29N R 5W</u>
Telephone No. <u>(601)-394-8587</u>	Distance <u>10</u> Miles <u>NE</u> Direction <u>28</u> Nearest Town <u>Rocky Creek, MS</u>

Pump Type Circle one	Power Type Circle one
Air Lift <input type="checkbox"/> Jet <input type="checkbox"/> <u>Submersible</u>	Diesel Engine <input type="checkbox"/> Gasoline Engine <input type="checkbox"/> Natural Gas <input type="checkbox"/>
Bucket <input type="checkbox"/> Piston <input type="checkbox"/> Turbine <input type="checkbox"/>	<u>Electric Motor</u> <input checked="" type="checkbox"/> Hand <input type="checkbox"/> Tractor PTO <input type="checkbox"/>
Centrifugal <input type="checkbox"/> Rotary <input type="checkbox"/> Flowing Well <input type="checkbox"/>	Windmill <input type="checkbox"/> Other (specify): _____
Other (specify): _____	Horse Power Rating of Motor: <u>1 hp</u>
Date Pump Installed: <u>6-28-17</u>	Setting Depth: <u>100 drop</u> feet
Rated Pump Capacity: <u>15</u> Gallons Per Minute	Number of Stages: <u>10</u>

RECEIVED

Pump Test Data	Method of Measuring Water Level Circle one
Date Well Tested: <u>6-28-17</u>	<u>Air Line</u> <input checked="" type="checkbox"/> Electric Measuring Line <input type="checkbox"/> <u>Steel Tape</u> <input type="checkbox"/>
Static Water Level (A): <u>5</u> Feet Below Land Surface	Other (specify): _____
Pumping Water Level (B): <u>70</u> Feet Below Land Surface	For flowing well, measured shut in head: _____ feet
Drawdown [(B) - (A)]: <u>2</u> Feet Below Land Surface	Well yielded <u>15</u> GPM with a drawdown of
Test Pumping Rate: <u>15</u> Gallons Per Minute	<u>2</u> feet after <u>48</u> hours of pumping
Duration of Pump Test (minimum 4 hours): <u>48</u> hours	

JUL 19 2017  
BY OLWR

I HEREBY CERTIFY that the above statements are true to the best of my knowledge.


Joel Pierce 0-780      Joel P  
 Print Name of Pump Installer and License No. (if applicable)      Signature of Pump Installer

Q49

The sketch below only required for water wells


Description of formations encountered must be provided for all wells and boreholes, unless specifically exempted by regulations

If well telescopes, show depths on sketch.

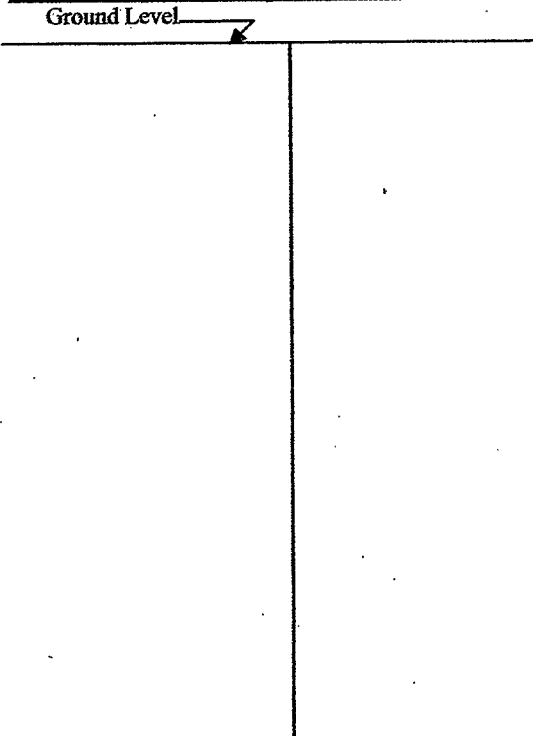

Description of Formations Encountered	From (depth) Ground Level	To (depth)
sand	0	35
clay	35	75
sand & gravel	75	113

If more than one screen, show location of each on sketch

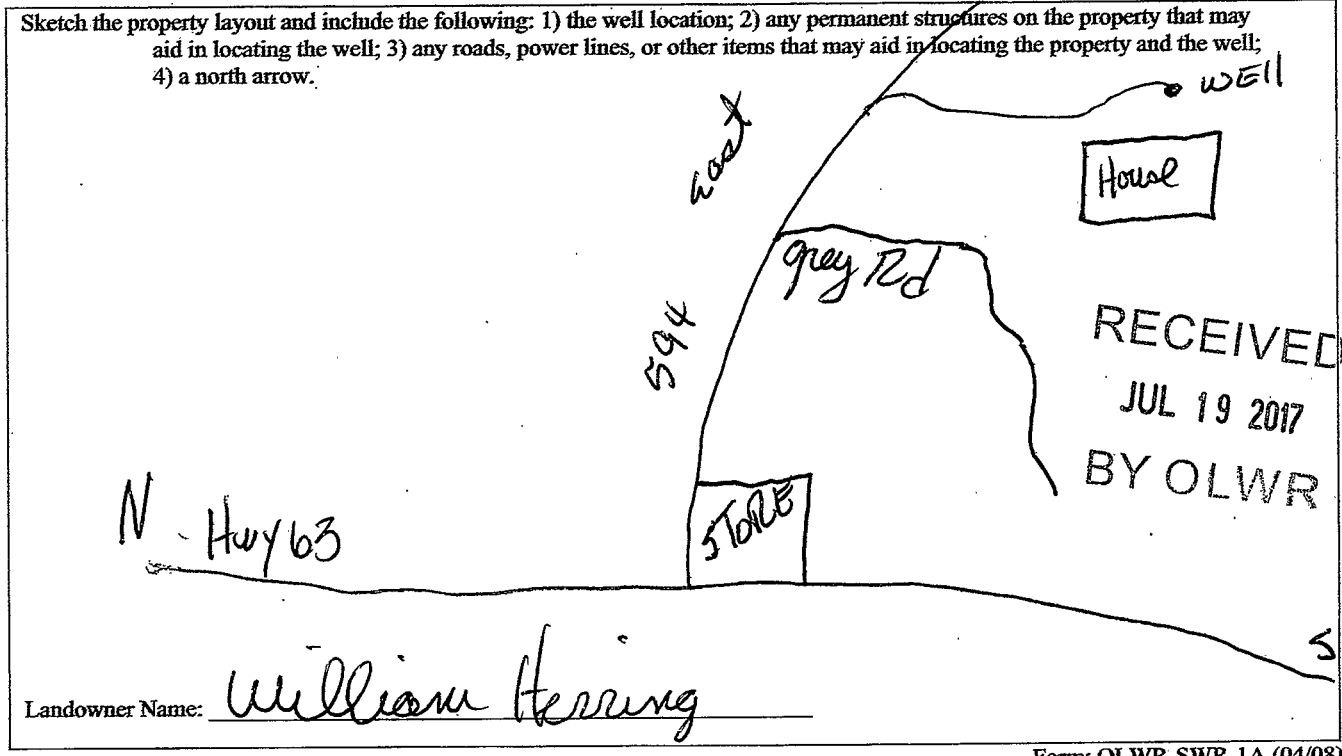

Form: OLWR-SWR-1A (04/08)

I certify that the well/borehole was drilled, constructed, and completed in accordance with all applicable requirements of the Mississippi Department of Environmental Quality and the Mississippi Department of Health regulations, if applicable, and state laws.

Joel Pierce 0780      6-28-17      Joel P.

Print Name of Responsible Licensee and License No.      Date      Signature of Licensee