


GREENE
 Q 2011
 1/22/81

MISSISSIPPI
 BOARD OF WATER COMMISSIONERS
 416 North State Street
 Jackson, Mississippi 39201
 WATER WELL DRILLERS LOG

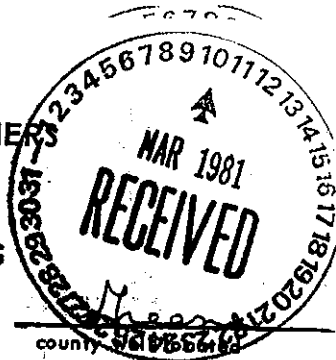

1-22-81 date well completed
 81 Frapje Wolf Simpson firm name
 county Harrison

LANDOWNER: Hicks
 Hicks Farm
 Leakesville, MS
 (mailing address)
 WELL LOCATION:
 23 sec. 1 T 2 R 5 E
 8 miles East of Leakesville
 (distance) (direction) (nearest town)

description of formations encountered	from	to
Top Soil	0	10
Sand	10	25
Clay	25	30
Sand	30	60
Clay	60	70
Coarse Sand	70	110

WELL PURPOSE:
 (home, irrigation, municipal, industrial)
 WELL COMPLETION DATA: 1-22-81
 (1) diameter (inches) 4"
 (2) total depth (feet) 120'
 (3) static water level (feet) 50' below top of ground.
 (4) casing PVC 90'
 (material) (depth)
 4" (size) if telescope see back.
 (5) screen 20' 90'
 (length) (depth to top)
 4" PVC (size) (material)
 (6) pump 1/2 20
 (HP) (yield gpm)
 E/S (type power)
 (7) electric log (yes or no)
 (organization running log)
 (8) how well bottom plugged 2" PVC
 Backwash

DRILLERS REMARKS:

