

R4

WATER WELL DRILLERS LOG

10-64

Date: Oct, 1964, Driller: Peoples Drilling Co County Green
 (Name)

(1) Owner of Land:	Description & Color of Materials Sand, Clay, Red Clay, Shell, etc.	Thick- ness Feet	Depth Feet
(Name) <u>Kittrell</u> (Address) <u>Mc Lain, Miss</u>	<u>Yellow clay</u>	<u>42</u>	<u>42</u>
(2) Location: <u>1/4</u> , <u>1/4</u> , Sec. <u>21</u> T <u>1</u> N R <u>8</u> W	<u>Blue clay & sandy clay</u>	<u>42</u>	<u>84</u>
<u>6</u> miles <u>SE</u> of <u>Mc Lain</u> (distance) (direction) (Nearest Town)	<u>Blue sand & silt</u>	<u>123</u>	<u>207</u>
(3) Topography: <u>Hilly</u> (Hilly) (Flat) (Level)	<u>White Sand & Gravel</u>	<u>30</u>	<u>237</u>
(4) Purpose of Well: <u>Home</u> (Domestic Irrigation Municipal, Industrial, Other)			


Information upon completion of well:

- (1) Diameter 2 inches.
- (2) Total Depth 237 feet.
- (3) Water Level 51 feet below top of ground.
- (4) Cased to 231', Size 2"
- (5) Screen: Size 2", Length 6'
- (6) Were any formations sealed against pollution?
 yes, no.

If YES depth of formation _____

Why _____

Drillers Remarks: _____

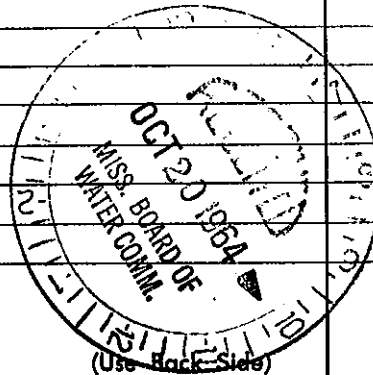

(Use Back Side)

Well No.