

R 5

5-20-64

WATER WELL DRILLERS LOG

Date: 5-30, 1964, Driller: Hattiesburg Butts County George

(Name)

(1) Owner of Land: <u>O. H. Bell</u> (Name)	Description & Color of Materials Sand, Clay, Red Clay, Shell, etc.	Thick- ness Feet	Depth Feet
<u>Bellevue, Miss.</u> (Address)	<u>Red sand</u>	<u>0-40</u>	
(2) Location: <u>1/4, 1/4, Sec. 1, T. 1 N, R. 3 W</u>	<u>Blue clay</u>	<u>40-160</u>	
<u>15 miles NW Lucedale</u> (distance) (direction) (Nearest Town)	<u>Blue sand</u>	<u>160-180</u>	
(3) Topography: <u>X</u> (Hilly) (Flat) (Level)			
(4) Purpose of Well: <u>domestic</u> (Domestic Irrigation Municipal, Industrial, Other)			

Information upon completion of well:

(1) Diameter 2 inches.

(2) Total Depth 180 feet.

(3) Water Level 30 feet below top of ground.

(4) Cased to _____, Size _____.


(5) Screen: Size 2", Length 10'.

(6) Were any formations sealed against pollution?
 _____ yes, X no.

If YES depth of formation _____

Why _____

Drillers Remarks: _____

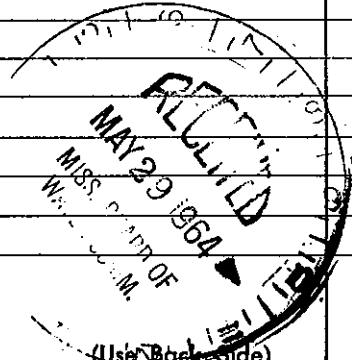

Well No.