

Greene

Mississippi Department of Environmental Quality
Office of Land and Water Resources
P.O. Box 10631
Jackson, MS 39289-0631
(601)961-5210
(601)354-6938 (fax)

Aquifer: _____
Well #: T-57
L. S. Elevation: _____
B-log #: _____

Permit #: _____
Driller: Mike & Wade
Date drilling completed: 10-18-06

State Law requires that this report be prepared by the driller in detail and filed with the Department within 30 days of completion of drilling of the well.

| Well Owner Information | Well Location |
|--------------------------------------------|----------------------------------------------------------------------------------|
| Owner Name: <u>Dan Pipberin</u> | Latitude: <u>31.03 878W</u> Longitude: <u>88.34.965W</u> |
| Mailing Address: <u>193 Green Eddie Rd</u> | Method of Lat/Long (circle one): <u>53</u> Conventional Survey, <u>58</u> |
| <u>Lumbal</u> <u>MS</u> <u>39452</u> | USGS quad, <u>Hand-held GPS</u> , Survey-grade GPS |
| City State Zip Code | <u>SW 1/4 NW 1/4 Sec 10</u> Twn <u>T1N</u> Rng <u>R6W</u> |
| Telephone No. () _____ | Distance Direction Nearest Town <u>5</u> Miles <u>S</u> of <u>Leaberville</u> |

Well Data

Purpose of Well (circle one) Home Industrial Public Supply Irrigation Fish Culture Other: _____

Date well drilling started: 10-18-06 Date well drilling completed: 10-18-06

If flowing, method of flow regulation: Valve _____ Other (describe) _____

Static Water Level: 20 feet above or below (circle one) land surface Date measured: _____

Method of Measurement (circle one) steel tape electric tape air line other: _____

Test depth: 40 Well depth: 40 Well grouted to a depth of 10 feet

Type of grout (circle one): Cement Bentonite Mix

Casing length: 35 feet Casing diameter: 2 inches Type of casing: PVC 40

Screen length: 5 feet Screen diameter: 2 inches Type of screen: PVC wrapped

Screen slot size: 8 inches Setting depth: From 35 feet to 40 feet

Type of completion (circle all applicable): Gravel packed Underreamed Telescoped Open hole Natural Development
Other (describe): _____

Top of lap pipe or reduction in casing: _____ feet. If telescoped or more than one screen, describe on back of page

Log run (circle all applicable): No log run Electric Gamma Ray Density Sonic Neutron Other: _____

Name of organization running log(s): _____

I certify that the well was drilled, constructed, and completed in accordance with all applicable requirements of the Mississippi Department of Environmental Quality and/or the Mississippi Department of Health regulations and state laws.

Michael R. FryFogle 0408
Print Name of Water Well Contractor and License No.

Michael R. FryFogle
Signature of Water Well Contractor

RECEIVED


DEC 29 2006

BY: OLWR

T-57

If well telescopes please sketch below and show depths.


Ground Level

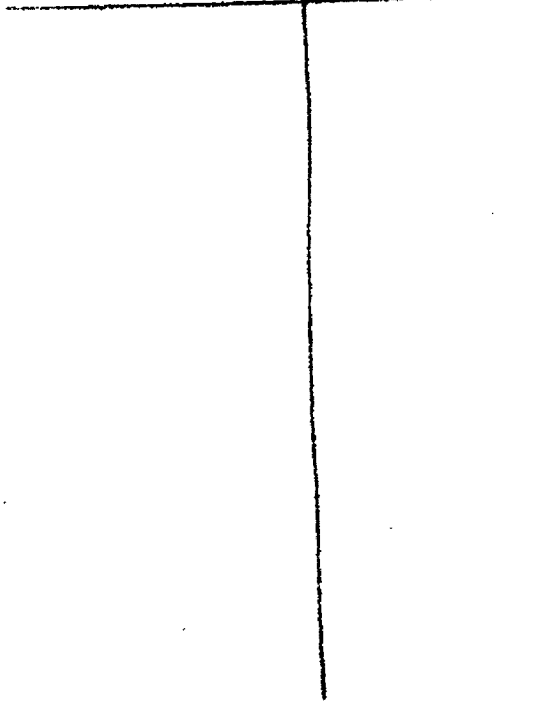

| Description of Formations Encountered | From | To |
|---------------------------------------|------|----|
| sand | 8 | 10 |
| Clay | 10 | 12 |
| rock | 12 | 40 |
| | | |
| | | |
If more than one screen, show location of each on sketch

Sketch the property layout and include the following: 1) the well location; 2) any permanent structures on the property that may aid in locating the well; 3) any roads, power lines, or other items that may aid in locating the property and the well; 4) indicate direction.

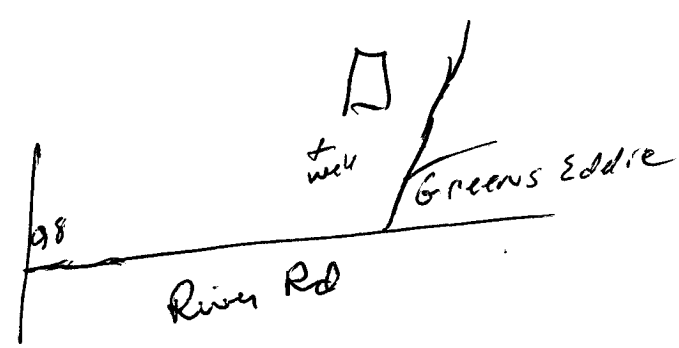

Landowner Name: Dan Pipkin

Michael R. Inghel 0408
 Signature of Water Well Contractor

RECEIVED
 DEC 29 2006
 BY: OLWR

STATE WELL REPORT

Part 2

Pump Installer's Completion Report
Mississippi Department of Environmental Quality
Office of Land and Water Resources
P.O. Box 10691
Jackson, MS 39289-0691
(601)961-5210
(601)354-6938 (fax)

For Office Use Only:

Aquifer: _____

Well #: T-57

Elevation: _____

County: Greene
 Permit #: _____
 Driller: Michael R. Fryfogel
 Date completed: 10-25-06

This report should be prepared by the pump installer in detail and filed with the Department within 30 days of the installation of pump.

Well Owner Information

Owner Name: Dan Pipkin
 Mailing Address: 193 Green Eddie Rd
Leucidal MS 39452
 City State Zip Code
 Telephone No. () _____

Well Location

Latitude: 31° 03' 878" N Longitude: 088° 34' 968" W
 Method of Lat/Long (circle one): Conventional Survey.
 USGS quad, Hand-held GPS, Survey-grade GPS
 _____ 1/4 _____ 1/4 Sec 10 Twp T1N Rng R6W
 Distance Direction Nearest Town
5 Miles S of Leakesville

Pump Type
Circle one

| | | |
|-------------|--------------------------------------|------------------------------------|
| Air Lift | <input checked="" type="radio"/> Jet | <input type="radio"/> Submersible |
| Bucket | <input type="radio"/> Piston | <input type="radio"/> Turbine |
| Centrifugal | <input type="radio"/> Rotary | <input type="radio"/> Flowing Well |

Other (specify): _____
 Date Pump Installed: 10-25-06
 Rated Pump Capacity: 8.12 Gallons Per Minute

Power Type
Circle one

| | | |
|-------------------------------------------------|---------------------------------------|-----------------------------------|
| <input checked="" type="radio"/> Diesel Engine | <input type="radio"/> Gasoline Engine | <input type="radio"/> Natural Gas |
| <input checked="" type="radio"/> Electric Motor | <input type="radio"/> Hand | <input type="radio"/> Tractor PTO |
| <input type="radio"/> Windmill | Other (specify): _____ | |

Horse Power Rating of Motor: 1
 Setting Depth: 35 feet
 Number of Stages: 2

Pump Test Data

Date Well Tested: _____
 Static Water Level (A): 20 Feet Below Land Surface
 Pumping Water Level (B): 30 Feet Below Land Surface
 Drawdown [(B) - (A)]: 10 Feet Below Land Surface
 Test Pumping Rate: 8 Gallons Per Minute
 Duration of Pump Test (minimum 4 hours): 4 hours

Method of Measuring Water Level
Circle one

| | | |
|-------------------------------------------|-----------------------------------------------|----------------------------------|
| <input checked="" type="radio"/> Air Line | <input type="radio"/> Electric Measuring Line | <input type="radio"/> Steel Tape |
|-------------------------------------------|-----------------------------------------------|----------------------------------|

Other (specify): _____
 For flowing well, measured shut in head: _____ feet
 Well yielded 8 GPM with a drawdown of
10 feet after 1 1/2 hours of pumping

I HEREBY CERTIFY that the above statements are true to the best of my knowledge.
Michael R Fryfogel 0408 Michael R Fryfogel
 Print Name of Pump Installer and License No. (if applicable) Signature of Pump Installer

RECEIVED
 DEC 29 2006
 BY OLWR