

Greene
U 20
4-19-74

MISSISSIPPI
BOARD OF WATER COMMISSIONERS CODED
416 North State Street
Jackson, Mississippi 39201

WATER WELL DRILLERS LOG
4-19-74 M+H Well Co. Green
date well completed firm name county well located

LANDOWNER: Clevis Brewer
Leaksville, Miss
(mailing address)

WELL LOCATION:
sec. 31 T. 1 N. R. 5 E.
10 miles S of Leaksville
(distance) (direction) (nearest town)


WELL PURPOSE: Home
(home, irrigation, municipal, industrial)

WELL COMPLETION DATA:

- (1) diameter (inches) 2"
- (2) total depth (feet) 105
- (3) static water level (feet) 40 ^{below} top of ground
- (4) casing Plastic 100
(material) (depth)
If telescope see back.
- (5) screen 5ft, 100
(length) (depth to top)
5ft, Plastic
(size) (material)
- (6) pump 1 12
(HP) (yield gpm)
Electric
(type power)
- (7) electric log _____
(yes or no)
- (8) how well bottom plugged Back
wash valve

description of formations encountered	from	to
Dirt	0	1
Sandy dirt	1	8
Red Clay	8	15
Purple Clay	15	21
Sand	21	25
Brown Clay	25	43
Yellow Clay	43	53
Gravel	53	65
Gravel & rock	65	66
Brown Clay	66	90
Sand	90	105

CODED

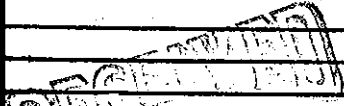

JUN 10 1974
MISS. BD. OF WATER COMM

DRILLERS REMARKS: