

Greene
U 21
2-20-75

MISSISSIPPI
 BOARD OF WATER COMMISSIONERS
 416 North State Street
 Jackson, Mississippi 39201

WATER WELL DRILLERS LOG

2/20 1975 M + H Hall Co Greene
 date well completed firm name county well located

LANDOWNER: Hall Truck Buick
Lucedale Miss
 (mailing address)

Description of formations encountered	from	to
Dirt	0	1
Red Dirt	1	11
Red Clay	11	22
Silt Sand	22	31
Blue Clay	31	189
Silt Sand	189	194
Coarse Sand	194	210


WELL LOCATION:
 sec. 11 T. 10 N. R. 5 E
6 miles SE of Shabazz
 (distance) (direction) (nearest town)

WELL PURPOSE: Home
 (home, irrigation, municipal, industrial)

WELL COMPLETION DATA:
 (1) diameter (inches) 2"
 (2) total depth (feet) 210
 (3) static water level (feet) 40 ^{below} _{above} top of ground.
 (4) casing Plastic, 200
 (material) (depth)
 (size) If telescope see back.
 (5) screen 10 FT, 200
 (length) (depth to top)
2" Plastic
 (size) (material)
 (6) pump 1 10
 (HP) (yield gpm)
Electric
 (type power)
 (7) electric log
 (yes or no)

(organization running log)
 (8) how well bottom plugged Back
wash valve

DRILLERS REMARKS:

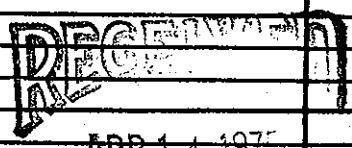

APR 14 1975