

**Greene**  
U 22  
2-4-75

MISSISSIPPI  
 BOARD OF WATER COMMISSIONERS  
 416 North State Street  
 Jackson, Mississippi 39201

WATER WELL DRILLERS LOG

2, 4, 19 75 M & H Well Co. Greene  
 Date well completed firm name county well located

LANDOWNERS: J. Bullock  
Leaksville, Miss  
 (mailing address)

description of formations encountered	from	to
Dirt	0	1
Red Dirt	1	11
Red Clay	11	21
Sand	21	27
Blue Clay	27	31
Silk Sand	31	35
Course Sand	35	40

WELL LOCATION:  
 sec. 11 T. 1 N. R. 5 E.  
6 miles S/E of Leaksville  
 (distance) (direction) (nearest town)

WELL PURPOSE: Home  
 (home, irrigation, municipal, industrial)

WELL COMPLETION DATA:

(1) diameter (inches) 2'

(2) total depth (feet) 210

(3) static water level (feet) 45 below top of ground

(4) casing Plastic 205  
 (material) (depth)

\_\_\_\_\_ If telescope see back.  
 (size)

(5) screen 5' 205  
 (length) (depth to top)

5' Plastic  
 (size) (material)


(6) pump 1 10  
 (HP) (yield/gpm)

Electric  
 (type power)

(7) electric log \_\_\_\_\_  
 (yes or no)

\_\_\_\_\_ (organization running log)

(8) how well bottom plugged Back  
wash valve

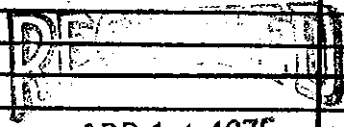

APR 14 1975

DRILLERS REMARKS: