

State Well Report

Part 1

Mississippi Department of Environmental Quality
Office of Land and Water Resources
P.O. Box 10631
Jackson, MS 39289-0631
(601)961-5210
(601)354-6938 (fax)

County: Greene
Permit #: _____
Driller: Michals, Howard
Date drilling completed: 5-14-07

For Office Use Only:
Aquifer: _____
Well #: U-71
L. S. Elevation: _____
E-log #: _____

State Law requires that this report be prepared by the driller in detail and filed with the Department within 30 days of completion of drilling of the well.

Well Owner Information	Well Location
Owner Name: <u>Eubanks Produce</u>	Latitude: <u>31° 00' 18" N</u> Longitude: <u>88° 29' 46" W</u>
Mailing Address: <u>331 Produce Rd</u>	Method of Lat/Long (circle one): <input type="checkbox"/> Conventional Survey, <input checked="" type="checkbox"/> <u>Hand-held GPS</u>
<u>Lucedale</u> MS <u>39452</u>	USGS quad, <u>NE 1/4 SW 1/4</u> Sec <u>33</u> Twn <u>T1N</u> Rng <u>R5W</u>
City State Zip Code	Distance <u>6</u> Miles Direction <u>N</u> of Nearest Town <u>Lucedale</u>
Telephone No. <u>(601) 947-9461</u>	

Well Data

Purpose of Well (circle one) Home Industrial Public Supply Irrigation Fish Culture Other: _____

Date well drilling started: 05-14-07 Date well drilling completed: 05-14-07

If flowing, method of flow regulation: Valve _____ Other (describe) _____

Static Water Level: 68 feet above or below (circle one) land surface Date measured: 05-17-07

Method of Measurement (circle one) steel tape electric tape air line other: _____

Hole depth: 100 Well depth: 100 Well grouted to a depth of 16 feet

Type of grout (circle one): Cement Bentonite Mix

Casing length: 80 feet Casing diameter: 4 inches Type of casing: PVC 540

Screen length: 010 feet Screen diameter: 4 inches Type of screen: PVC WOP

Screen slot size: .010 inches Setting depth: From 80 feet to 100 feet

Type of completion (circle all applicable): Gravel packed Underreamed Telescoped Open hole Natural Development

Other (describe): _____

Top of lap pipe or reduction in casing: _____ feet. **If telescoped or more than one screen, describe on back of page**

Logs run (circle all applicable): No log run Electric Gamma Ray Density Sonic Neutron Other: _____

Name of organization running log(s): _____

I certify that the well was drilled, constructed, and completed in accordance with all applicable requirements of the Mississippi Department of Environmental Quality and/or the Mississippi Department of Health regulations and state laws.

Michael S. Howard 0-693
Print Name of Water Well Contractor and License No.

[Signature]
Signature of Water Well Contractor

RECEIVED
JUN 18 2007
BY: OLWR

U-71


If well telescopes please sketch below and show depths.


Ground Level

Description of Formations Encountered	From	To
Top sand	0	5
Sand (mix)	5	18
Clay	18	25
Silt	25	32
Clay	32	68
Sand (med)	68	110

If more than one screen, show location of each on sketch

Sketch the property layout and include the following: 1) the well location; 2) any permanent structures on the property that may aid in locating the well; 3) any roads, power lines, or other items that may aid in locating the property and the well; 4) indicate direction.

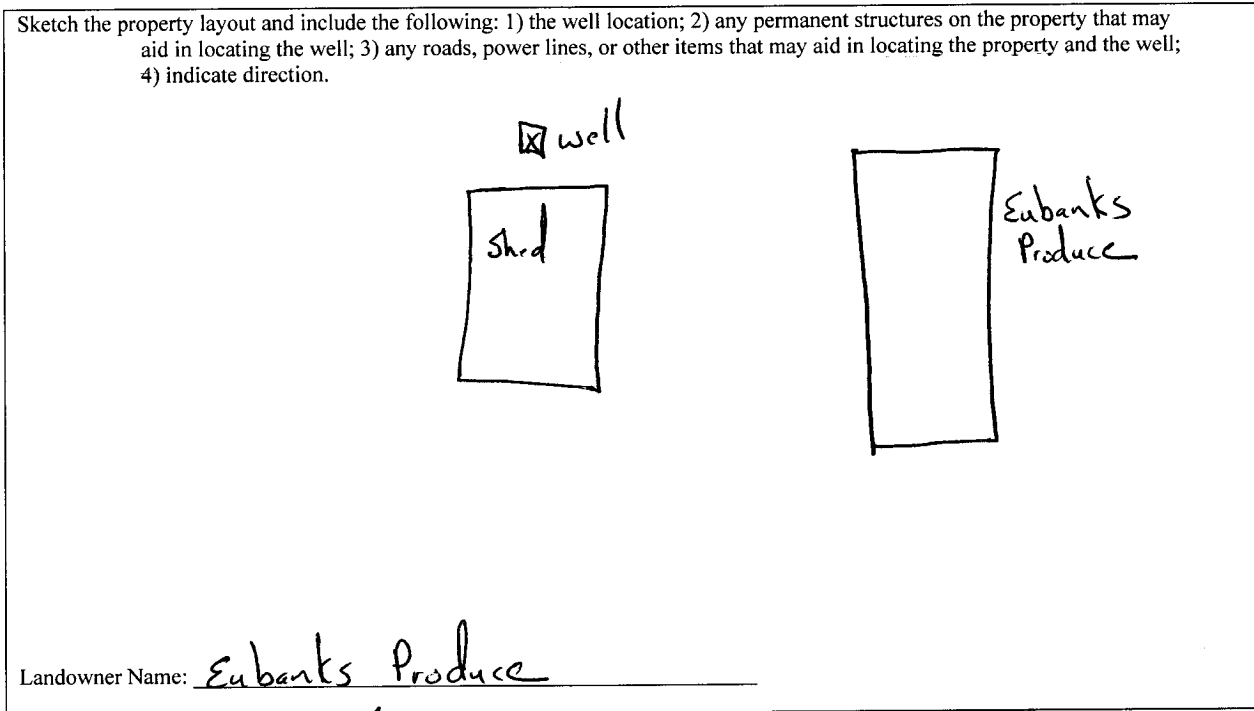

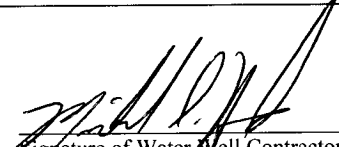

 Signature of Water Well Contractor

RECEIVED
 JUN 18 2007
 BY OLWA

STATE WELL REPORT

Part 2

Pump Installer's Completion Report
 Mississippi Department of Environmental Quality
 Office of Land and Water Resources
 P.O. Box 10631
 Jackson, MS 39289-0631
 (601)961-5210
 (601)354-6938 (fax)

County: Greene
 Permit #: _____
 Driller: Michael S. Harvard
 Date completed: 5-17-07

For Office Use Only:

Aquifer: _____
 Well #: U-71
 Elevation: _____

This report should be prepared by the pump installer in detail and filed with the Department within 30 days of the installation of pump.

Well Owner Information	Well Location
Owner Name: <u>Eubanks Produce</u>	Latitude: <u>N31°00.18</u> Longitude: <u>W88°29.79</u>
Mailing Address: <u>331 Produce Ln</u>	Method of Lat/Long (circle one): Conventional Survey, USGS quad: <u>Hand-held GPS</u> , Survey-grade GPS
<u>Lucedale</u> MS <u>39452</u>	¼ _____ ¼ Sec <u>33</u> Twn <u>T1N</u> Rng <u>R5W</u>
City State Zip Code	Distance Direction Nearest Town
Telephone No. <u>(601) 947-9661</u>	<u>6</u> Miles <u>N</u> of <u>Lucedale</u>

Pump Type Circle one	Power Type Circle one
Air Lift Jet <u>Submersible</u>	Diesel Engine Gasoline Engine Natural Gas
Bucket Piston Turbine <u>Electric Motor</u>	Hand Tractor PTO
Centrifugal Rotary Flowing Well	Windmill Other (specify): _____
Other (specify): _____	Horse Power Rating of Motor: _____
Date Pump Installed: <u>05-17-07</u>	Setting Depth: <u>96</u> feet
Rated Pump Capacity: <u>85</u> Gallons Per Minute	Number of Stages: <u>15</u>

Pump Test Data	Method of Measuring Water Level Circle one
Date Well Tested: <u>5-17-07</u>	Air Line Electric Measuring Line <u>Steel Tape</u>
Static Water Level (A): <u>68</u> Feet Below Land Surface	Other (specify): _____
Pumping Water Level (B): <u>95</u> Feet Below Land Surface	For flowing well, measured shut in head: _____ feet
Drawdown [(B) - (A)]: <u>27</u> Feet Below Land Surface	Well yielded <u>105</u> GPM with a drawdown of
Test Pumping Rate: <u>105</u> Gallons Per Minute	<u>27</u> feet after <u>4.5</u> hours of pumping
Duration of Pump Test (minimum 4 hours): <u>4.5</u> hours	

I HEREBY CERTIFY that the above statements are true to the best of my knowledge.

Michael S. Harvard 0-673 _____
 Print Name of Pump Installer and License No. (if applicable) Signature of Pump Installer

RECORDED
 JUN 18 2007
 5:00 PM