	State W	ell Report		
County: Greene		Part 1	For Office Use Only:	
Permit #:	Mississippi Department of Environmental Quality		Aquifer:	
		and Water Resources	Well #: <u>U - 72</u>	
Driller: Michael S. Havard	P.O. Box 10631 Jackson, MS 39289-0631		L. S. Elevation:	
Date drilling completed: 06-25-07	(601)	961-5210		
	(601)35	4-6938 (fax)	E-log #:	
State Law requires that this report be prepared by the driller in detail and filed with the Department within 30 days of completion of drilling of the well.				
Well Owner Information		Well Location		
Owner Name Terrill Green		Latitude: <u>31 ° 02 ' 23</u>	'' Longitude: <u>88 ° 31 ' 85 '</u> ''	
Mailing Address: 243 OIDEDith RD		Method of Lat/Long (circle or		
			GPS Survey-grade GPS	
Lucedale Ms 39452 City State Zip Code		<u>SW 1/2 NW 1/2 Sec 19</u>	Twn TIN Rng KSW	
		Distance Direction Nearest Town <u>3</u> Miles <u>N</u> of <u>County line Hury 63</u>		
Telephone No. ( 601 ) 947-284	5		01 County INC Hunge CJ	
·				
Well Data				
Purpose of Well (circle one) Industrial Public Supply Irrigation Fish Culture Other:				
Date well drilling started:   06-25-07     Date well drilling completed:   06-25-07				
If flowing, method of flow regulation: Valve Other (describe)				
Static Water Level: 103 feet above or below (circle one) land surface Date measured: 6-25-07				
Method of Measurement (circle one) electric tape air line other:				
Hole depth: <u>145</u> Well depth: <u>145</u> Well grouted to a depth of <u>15</u> feet				
Type of grout (circle one): Cement Bentonite				
Casing length: <u>135</u> feet Casing diameter: <u>2</u> inches Type of casing: <u>PVC 540 BE</u>				
Screen length: 10 feet Screen diameter: 2 inches Type of screen: 30				
Screen slot size: <u></u>	Setting depth: From _	135 feet to 14	<u>feet</u>	
Type of completion (circle all applicable): Gravel packed Underreamed Telescoped Open hole Natural Development				
	Other (describe):			
Top of lap pipe or reduction in casing:feet. If telescoped or more than one screen, describe on back of page				
Logs run (circle all applicable) So log run Electric Gamma Ray Density Sonic Neutron Other:				
Name of organization running log(s): I certify that the well was drilled, constructed, and completed in accordance with all applicable requirements of the Mississippi				
Department of Environmental Quality and/or the Mississippi Department of Health regulations and state laws				
Michael S. Havard 0-673 Michael S. Havard 0-673				
Print Name of Water Well Contractor and License No. Signature of Water Well Contractor				

۰ ۸

AUG 13 2007 · BY: CLWB

U - 72

If well telescopes please sketch below and show depths.


Ground Level

1

.,

Description of Formations Encountered	From	То
1		
Topsand	0	10
Clay	10	15
Clayer	15	30
Sand	30	UV
Clay.	40	60
Sand	60	70
lock	70	71
Chy	71	90
Sand	90	100
Clay	100	125
Sand	125	145
		1
		[
	1	
- <u> </u>		
		I

If more than one screen, show location of each on sketch

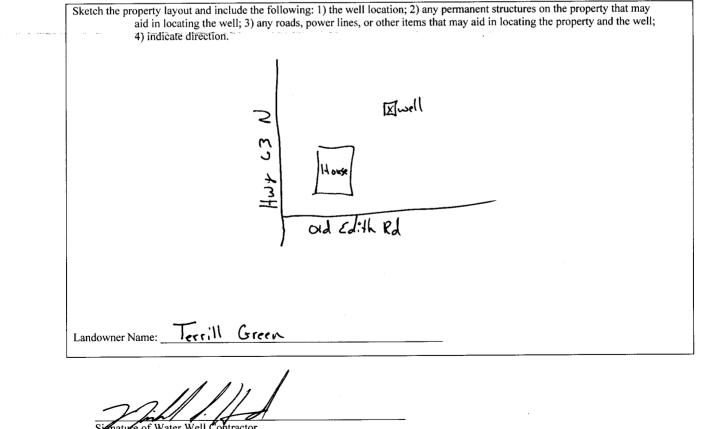

Signature of Water Well Contractor

RECEIVED AUG 1 3 2007 BVOWR

STATE W	ELL REPORT	
County: Green C Pump Installer Permit #: Mississippi Departme Office of Land P.O. Jackson, Date completed: 0.25-07 (60)	Part 2 For Office Use Only: Aquifer: Aquifer: MS 39289-0631 1)961-5210 54-6938 (fax) For Office Use Only: Aquifer: Well #: U-72 Elevation:	
This report should be prepared by the pump installer in det installation of pump.		
Well Owner Information	Well Location	
Owner Name: Terrill Green Mailing Address: 243 OLD Edith Rd	Latitude: <u>N31°62, 23</u> Longitude: <u>U88°31.85</u> Method of Lat/Long (circle one): Conventional Survey, USGS quad, Hand-held GP3, Survey-grade GPS	
Lucedale MS 39452 City State Zip Code Telephone No. (601) 947-2845	<u>14</u> <u>14 Sec <u>19</u> Twn <u>TIN</u> Rng <u>R5</u> Distance Direction Nearest Town <u>3</u> Miles <u>N</u> of <u>County Line 63</u> W</u>	
Pump Type   Circle one	Power Type Circle one Diesel Engine Gasoline Engine Natural Gas	
Bucket Piston Turbine	Etectric Motor Hand Tractor PTO	
Centrifugal Rotary Flowing Well	Windmill Other (specify):	
Other (specify):	Horse Power Rating of Motor: 1.5 HP	
Date Pump Installed:	Setting Depth: 135 feet	
Rated Pump Capacity: 7 Gallons Per Minute	Number of Stages: 3	
Pump Test Data	Method of Measuring Water Level Circle one	
Date Well Tested:	Air Line Electric Measuring Line Steel Tape	
tatic Water Level (A): <u>103</u> Feet Below Land Surface Pumping Water Level (B): <u>110</u> Feet Below Land Surface	Other (specify):	
Drawdown [(B) – (A)]:Feet Below Land Surface	For flowing well, measured shut in head:feet	
Test Pumping Rate:Gallons Per Minute	Well yielded GPM with a drawdown of	
Duration of Pump Test (minimum 4 hours):hours	feet after 4 hours of pumping	
I HEREBY CERTIFY that the above statements are true to the best of $M: d$ $S$ . $f: d$ $ava(d)$ $O - 6.73$ Print Name of Pump Installer and License No. (if applicable)	of my knowledge. Signature of Pump Installer	

٣

AUG 1,3 2007 BV: OI WR