

State V	Vell Report				
	Driller's Log For Office Use Only:				
Mississippi Departmer	nt of Environmental Quality Aquifer:				
Permit #: Office of Land	and Water Resources Wall # 11 95				
Driller PLANAL S. Mayalox	B0x 10051				
-	MS 39289-0631 L. S. Elevation:				
(601)35	54-6938 (fax) E-log #:				
State Law requires that this report be prepared by the lic Department at the above address within 30 days of com					
Information on Well Owner	Well or Borehole Location				
(Landowner if borehole is not for a water well)	Latinda, 31 , 00, 18 " Lansituda, 82, 29, 31 "				
Owner Name Fubruks Produce	Latitude: $31 \circ 00^{\circ}$, 10° Longitude: $88 \circ 29^{\circ}$, 31° 09° Method of Lat/Long (circle one): Conventional Survey,				
Mailing Address: 331 Produce Road	Method of Lat/Long (circle one): Conventional Survey,				
Mailing Address: 331 Frodu C Koad	USGS quad, Hand-held GPS, Survey-grade GPS				
1 1 1 1 1 1 1 1 1 1	NW 14 SE 14 Sec 33 Twn TIN Rng RSW				
Luccdale MS 39452 City State Zip Code	Distance Direction Nearest/Town 6 Miles of Lucidate				
Telephone No. (40() 947 - 9661	<u>6</u> Miles N of Lucrdale				
Well / Bor	ehole Data				
Date drilling started: 2.19-09 Date drilling completed: 2.19-09 Hole depth: 102 Hole diameter: 7.5					
Location of the source of any surface water used for drilling:					
Method of dosing and volume of Chlorine used in drilling and deve	lopment:				
Logs run (circle all applicable): No log run Electric Gamma Ray Name of organization running log(s):	Density Sonie Neutron Other:				
Purpose of borehole (check one): Water Well X Geotechnical/Geo	logical Investigation Ground Source Heat Pump				
If drilling is not related to water well construction	e) on, skip the remainder of this block				
Purpose of Well (check one): Home 😰 Industrial Public Suppl	y Irrigation X_ Fish Culture Other:				
If a flowing well, method of flow regulation: Valve O	Other (describe)				
Static Water Level: 68 feet above or below (circle one) land surface Date measured:					
Method of Measurement (circle one) steel tape electric tape air line other:					
Well depth: 102 Well grouted to a depth of 15 feet Type of grout (circle one): Neat Cement Bentonite Mix					
Casing length: 92 feet Casing diameter: 4 inches Type of casing: $PUC SYO BE$					
Screen length: <u>20</u> feet Screen diameter: <u>Y</u> inches Type of screen: <u>WOP SYO</u>					
Screen slot size: 100 inches Setting depth: From 92 feet to 102 feet					
Type of completion (circle all applicable): Enavel packed Underreamed Telescoped Open hole Natural Development					
Other (describe):					
Top of lap pipe or reduction in casing:feet. If telescoped or more than one screen, describe on next page					
	Form: OLWR-SWR-1				

ng 🚽

MAR 1 9 2009 BY: OLWR The sketch below only required for water wells

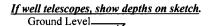


4

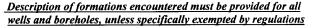

Description of Formations Encountered	From (depth) Ground Level	3
silf-	3	2
Sand (line: mid)	22	3
Sand (m.d)	36	2.
Clay .	72	7.
Sant (mid)	80	10
•		
· · · · · · · · · · · · · · · · · · ·		
· · · · · · · · · · · · · · · · · · ·		
· · · · · · · · · · · · · · · · · · ·		

If more than one screen, show location of each on sketch

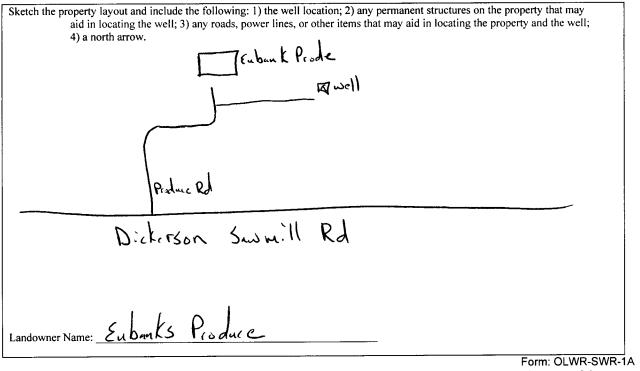

I certify that the well/borehole was drilled, constructed, and completed in accordance with all applicable requirements of the Mississippi Department of Environmental Quality and the Mississippi Department of Health regulations, if applicable, and state

laws. 0-693 03-05-09 M Date

Print Name of Responsible Licensee and License No.

Signature of Licensee

RECEIVED MAR 1 9 2009 BY: OLWR

STATE WELL REPORT				
Permit #: Mississippi Driller: Michia S. Havaid Office	Part 2Installer's Completion ReportDepartment of Environmental Quality e of Land and Water Resources P.O. Box 10631Jackson, MS 39289-0631 (601)961-5210 			
This part of the report must be completed by a licensed w	water well contractor or a licensed pump installer. A copy of Part 1 of the			
report must be attached and both parts filed with the Dep Well Owner Information	partment at the above address within 30 days of well completion. Well Location			
Owner Name: Eubanks Produce Mailing Address: 331 Produce Rd	Latitude: <u>N31° 00 . 15</u> Longitude: <u>N98° 29 . 31</u> Method of Lat/Long (check one): Conventional Survey,			
Luccarle MS 3945 City State Zip Coo	de Distance Direction Nearest Town			
Telephone No. (<u>Col</u>) 947 9461	C Miles _ D of Lucdale			
Pump Type Circle one	Power Type Circle one			
Air Lift Jet Submersible	Diesel Engine Gasoline Engine Natural Gas			
Bucket Piston Turbine	Electric Motor Hand Tractor PTO			
Centrifugal Rotary Flowing Wel	Il Windmill Other (specify):			
Other (specify):	Horse Power Rating of Motor:			
Date Pump Installed: 2 . 19 - 0 9	Setting Depth:feet			
Rated Pump Capacity: <u>35</u> Gallons Per M	linute Number of Stages:			
Pump Test Data Date Well Tested: 2-19-09	Method of Measuring Water Level Circle one			
Static Water Level (A): <u>68</u> Feet Below Land St Pumping Water Level (B): <u>80</u> Feet Below Land St	Other (specify):			
Drawdown [(B) – (A)]: γ Feet Below Land St	<i>L</i>			
Test Pumping Rate: <u>50</u> Gallons Per M Duration of Pump Test (minimum 4 hours): <u>4</u>	Linute Well yielded 50 GPM with a drawdown of hours 12 feet after 4			
I HEREBY CERTIFY that the above statements are true to M.ch.a.S.Hava(d) D-673 Print Name of Pump Installer and License No. (if applicab	Mal I. Hot			
	MAR 1 9 200			

6 · *

	. .		
BY:	OL	W.	R