

STATE WELL REPORT

282

County: Greene
 Permit #: _____
 Driller: Michael S. Haverd
 Date drilling completed: 2-02-2021

Part 1
Driller's Log
 Mississippi Department of Environmental Quality
 Office of Land and Water Resources
 P.O. Box 2309
 Jackson, MS 39225-2309
 (601)961-5555
 (601)961-5228 (fax)

For Office Use Only:

Well #: U 134
 Aquifer: _____
 E-Log #: _____

State Law requires that this report be prepared by the license holder responsible for the work and filed with the Department at the above address within 30 days of completion of drilling of the well or borehole.

Well Owner Information <small>(Landowner if borehole is not for a water well)</small>	Well or Borehole Location
Owner Name: <u>Eubanks Produce R32</u>	Latitude: <u>31° 2' 35.85" N</u> Longitude: <u>88° 27' 22.56" W</u>
Mailing Address: <u>331 Produce Road</u>	Method of Lat/Long (check one): Conventional Survey _____, USGS quad _____, Hand-held GPS _____, Survey-grade GPS _____
<u>Lucedale</u> MS <u>39452</u>	<u>SW</u> ¼ <u>SE</u> ¼, Sec. <u>14</u> T <u>T1N</u> R <u>R5W</u>
City State Zip Code	<u>9.66</u> Miles <u>SE</u> of <u>Leakesville</u>
Telephone No. (601) <u>947-9661</u>	(Distance) (Direction) (Nearest Town)

Well / Borehole Data

Date drilling started: 2-01-2021 Date drilling completed: 2-02-2021 Hole depth: 235 Hole diameter: 7.5

Location of the source of any surface water used for drilling: _____

Method of dosing and volume of Chlorine used in drilling and development: _____

Logs run (check all applicable): log run Electric Gamma Ray Density Sonic Neutron Other: _____

Name of organization running log(s): _____

Purpose of borehole (check one): Water Well Geotechnical/Geological Investigation Ground Source Heat Pump Seismic Survey Other (describe) _____

If drilling is not related to water well construction, skip the remainder of this block

Purpose of Well (check all applicable): Home Industrial Public Supply Irrigation Fish Culture

Other (describe): _____

If a flowing well, method of flow regulation: Valve _____ Other (describe) _____

Static Water Level: 135 feet above or below land surface Date measured: 2-03-2021
(check one)

Method of measurement (check one) Steel tape Electric tape Air line Other (describe): _____

Well depth: 235 Well grouted to a depth of: 15 feet Type of grout (check one) Neat Cement Bentonite Mix

Casing length: 215 feet Casing diameter: 4 inches Type of casing: PVC 540

Screen length: 20 feet Screen diameter: 4 inches Type of screen: PVC WOP

Screen slot size: .010 inches Setting depth: From 215 feet to 235 feet

Type of completion (check all applicable) gravel packed Underreamed Open hole Natural Development

Other (describe): _____

Top of lap pipe or reduction in casing: _____ feet

If telescoped or more than one screen, describe on next page

RECEIVED
 MAR 24 2021
 BY OLWR

STATE WELL REPORT

Part 2

Pump Installer's Completion Report
 Mississippi Department of Environmental Quality
 Office of Land and Water Resources
 P.O. Box 2309
 Jackson, MS 39225-2309
 (601)961-5210
 (601) 360-0535 (fax)

For Office Use Only:

Well #: U 134
 Aquifer: _____

County: Greene
 Permit #: _____
 Driller: Michael S. Harvard
 Date completed: 2-05-2021
Copy information from block on Part 1

This part of the report must be completed by a licensed water well contractor or a licensed pump installer. A copy of Part 1 of the report must be attached and both parts filed with the Department at the above address within 30 days of well completion.

Well Owner Information	Well Location
Owner Name: <u>Eubanks Produce R32</u>	Latitude: <u>31° 2' 35.85" N</u> Longitude: <u>88° 27' 22.56" W</u>
Mailing Address: <u>331 Produce Road</u>	Method of Lat/Long (check one): Conventional Survey _____, USGS quad _____, Hand-held GPS _____, Survey-grade GPS _____
<u>Lucedale</u> <u>MS</u> <u>39452</u>	<u>SW</u> ¼ <u>SE</u> ¼, Sec <u>14</u> T <u>T1N</u> R <u>R5W</u>
City State Zip Code	<u>9.66</u> Miles <u>SE</u> of <u>Leakesville</u>
Telephone No. (601) <u>947-9461</u>	(Distance) (Direction) (Nearest Town)

Pump Type (check one)

Submersible: Turbine Air Lift Centrifugal Flowing Well Jet Piston Rotary Other (describe): _____

Date Pump Installed: 2-06-2021 Rated Pump Capacity: 55 Gallons Per Minute

Is This Pump (check one): New Repaired Replacement

Power Type (check one)

Electric Diesel Gasoline Natural Gas Tractor PTO Windmill Other (describe): _____

Horse Power Rating of Motor: 5 Setting Depth: 210 feet Number of Stages: 11

Pump Test Data for Non Flowing Well

Date Well Tested: 2-06-2021 Duration of Pump Test (minimum 4 hours): _____ hours

Static Water Level (A): 135 Feet Below Land Surface Pumping Water Level (B): 155 Feet Below Land Surface

Drawdown [(B) - (A)]: 20 Feet Below Land Surface Test Pumping Rate: 75 Gallons Per Minute

Method of measurement (check one): Steel tape Electric tape Air line Other (describe): _____

Pump Test Data for Flowing Well

Measured shut in head: _____ feet.

Well yielded _____ GPM with a drawdown of _____ feet after _____ hours of pumping

Meter Installation

Meter Manufacturer: _____ Meter Serial Number: _____

Meter Model Number/Name: _____ Type of Meter: _____

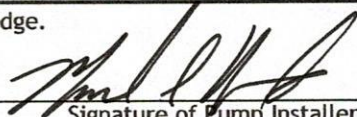
Totalizer Register Unit and Multiplier Factor (AF x .001, gal x 1000, etc): _____

Installation Date: _____ Meter installed by: _____

Is This Meter (check one): New Repaired Replacement

Important: By submitting the above information you are certifying that this meter was installed to manufacturer standards. For agricultural wells, a list of approved meters is on the MDEQ website.

I HEREBY CERTIFY that the above statements are true to the best of my knowledge.

Michael S. Harvard 0-673 2-15-2021 

Print Name of Pump Installer and License No. (if applicable) Date Signature of Pump Installer

Eubanks Produce

R32

Legend
R28

Duett Rd

R32

Brushy Creek Rd

Google Earth

© 2021 Google

800 ft

