


**GREENE**  
 U 2005  
 5-20-76

MISSISSIPPI  
 BOARD OF WATER COMMISSIONERS  
 416 North State Street  
 Jackson, Mississippi 39201

WATER WELL DRILLERS LOG

5-20-1976 date well completed  
 13R The Summit Drilling Co. firm name  
 Greene county well located

LANDOWNER	description of formations encountered	from	to
Mr. M. C. Cooley Jr. R.F.D. 5 Tuculobla miss. (mailing address)	hard clay	0	13
	Red sand	13	21
WELL LOCATION: sec. 4 T-1 N-5 R-5 E 14 miles N Tuculobla (distance) (direction) (nearest town)	hard clay	21	32
	clay	32	102
WELL PURPOSE: Home (home, irrigation, municipal, industrial)	shale	102	129
WELL COMPLETION DATA: (1) diameter (inches) 2" (2) total depth (feet) 145 ft (3) static water level (feet) 116 below above top of ground. (4) casing Plastic 140 ft (material) (depth) 2" (size) if telescope see back. (5) screen 5 ft 145 (length) (depth to top) 2" Plastic (size) (material) (6) pump 2 (HP) 7 (yield gpm) jet (type power) (7) electric log yes or no (organization running log) (8) how well bottom plugged blue	blue clay	129	132
	Red sand	132	145
DRILLERS REMARKS:			

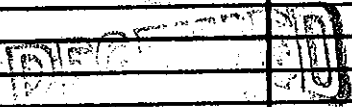

MAY 25 1976

MISS. BD. OF WATER COMM.