

**GRENADA MISSISSIPPI BOARD OF WATER COMMISSIONERS**

**A1**

**WATER WELL DRILLERS LOG**


**8-8-65**

Date: AUG 8, 1965, Driller: DELTA DRINKING Co County: Grenada

E Log #37

(Name)

		Description & Color of Materials Sand, Clay, Red Clay, Shell, etc.	Thick- ness Feet	Depth Feet
(1) Owner of Land: <u>O. L. PURYEAR</u> <u>DUMAS, ARK.</u> (Name) <u>SUNRAY OIL Co</u>		<u>CLAY</u>	<u>25</u>	<u>25</u>
Well Location: <u>Grenada, Miss</u> (Address) <u>SENE</u>		<u>Shale</u>	<u>20</u>	<u>45</u>
(2) Location: <u>SW 1/4, SW 1/4, Sec. 14 T23N4E</u>		<u>Clay</u>	<u>31</u>	<u>76</u>
_____ miles _____ of _____ (distance) (direction) (Nearest Town)		<u>Shale</u>	<u>95</u>	<u>171</u>
(3) Topography: _____ (Hilly) (Flat) (Level)		<u>GREY Sand</u>	<u>64</u>	<u>235</u>
(4) Purpose of Well: <u>INDUSTRIAL</u> (Domestic Irrigation, Municipal, Industrial, Other)		<u>Shale w/Rocks</u>	<u>43</u>	<u>278</u>
Information upon completion of well:		<u>Sand</u>	<u>18</u>	<u>296</u>
(1) Diameter: <u>4</u> inches.		<u>Shale</u>	<u>35</u>	<u>331</u>
(2) Total Depth: <u>809</u> feet.		<u>Gumbo</u>	<u>50</u>	<u>381</u>
(3) Water Level _____ feet below top of ground.		<u>Shale w/Rocks</u>	<u>41</u>	<u>422</u>
(4) Cased to <u>2.84</u> , Size <u>4x2"</u>		<u>Gumbo</u>	<u>102</u>	<u>524</u>
(5) Screen: Size <u>2"</u> , Length <u>10'</u>		<u>Shale</u>	<u>75</u>	<u>599</u>
(6) Were any formations sealed against pollution? _____ yes, _____ no.		<u>Gumbo</u>	<u>10</u>	<u>609</u>
If YES depth of formation _____		<u>Shale</u>	<u>20</u>	<u>629</u>
Why _____		<u>Fine Sand</u>	<u>10</u>	<u>639</u>
Drillers Remarks: <u>30' - 2" Blank Pipe</u>		<u>Shale</u>	<u>49</u>	<u>688</u>
<u>On bottom of Screen.</u>		<u>Fine Sand</u>	<u>20</u>	<u>708</u>
		<u>Shale</u>	<u>31</u>	<u>739</u>
		<u>Gumbo</u>	<u>29</u>	<u>768</u>
		<u>Shale</u>	<u>41</u>	<u>809</u>

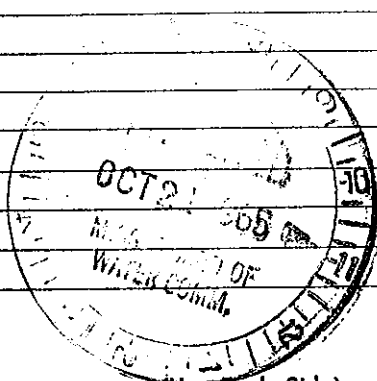

Mail this copy to Board of Water Commissioners 429 Miss. St. Jackson, Miss.