

GW
02070

Grenada
A 2
6-68
USGS

MISSISSIPPI
BOARD OF WATER COMMISSIONERS
416 North State Street
Jackson, Mississippi 39201

CODED

WATER WELL DRILLERS LOG

June 1968 Robert E. Kattiff, Grenada
date well completed GT4Y WA firm name county well located


LANDOWNER: Geeston
Corner Water Assn.
Grenada, Miss.
(mailing address)

description of formations encountered	from	to
Clay	0	14
sand	14	48
shale	48	150
sand	150	190
sand shales & shale	190	286
shale	286	510
sand	510	525
shale	525	532
sand	532	550
shale	550	555
sand	555	564
shale	564	638
sand	638	653

WELL LOCATION:
sec. 26 T. 23 N. R. 4 E
4 miles North of Grenada
(distance) (direction) (nearest town)

WELL PURPOSE: Community Water
(home, irrigation, municipal, industrial)

- WELL COMPLETION DATA:
- (1) diameter (inches) 8 x 4
 - (2) total depth (feet) 653
 - (3) static water level (feet) 6 below above top of ground.
 - (4) casing B. St. 510'
8" (material) (depth)
8" (size) if telescope see back.
 - (5) screen 56' 510'
(length) (depth to top)
4" S.S.
(size) (material)
 - (6) pump 20 150
(HP) (yield gpm)
electric
(type power)
 - (7) electric log yes (yes or no) (E-log # 44)
U.S.G.S.
(organization running log)
 - (8) how well bottom plugged BPU

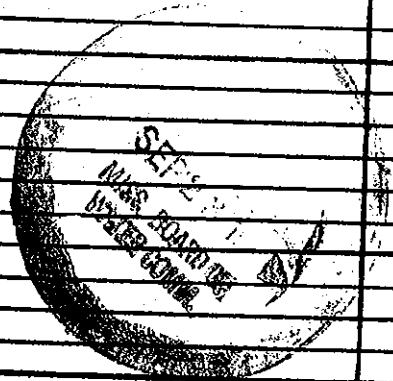

DRILLERS REMARKS: 87' g 4"
pipe between screen
lengths in sand.