

GRENADA

Q A 3

WATER WELL DRILLERS LOG

Grenada

10-1-61

Date: 10-1, 1961, Driller: Joe P. Lysen County: Pandora
(Name) 03000

(1) Owner of Land	Description & Color of Materials Sand, Clay, Red Clay, Shell, etc.	Thick- ness Feet	Depth Feet
<u>Billy Nutter?</u> (Name)	<u>Sh & sand</u>	<u>0</u>	<u>40</u>
<u>Pandora, Miss</u> (Address)	<u>soft & gravel</u>	<u>40</u>	<u>11</u>
(2) Location: <u>1/4</u> , <u>1/4</u> , Sec. <u>3</u> <u>T</u> <u>N</u> <u>R</u> <u>E</u>	<u>Blk. clay</u>	<u>100</u>	<u>157</u>
<u>3</u> miles <u>West</u> , of <u>Nardly</u> (distance) (direction) (Nearest Town)	<u>upcoming sand</u>	<u>50</u>	<u>177</u>
(3) Topography: <u>Hilly</u> (Hilly) (Flat) (Level)			
(4) Purpose of Well: <u>Domestic</u> (Domestic Irrigation Municipal, Industrial, Other)			


Information upon completion of well:

- (1) Diameter 2 inches.
- (2) Total Depth 177 feet.
- (3) Water Level 50 feet below top of ground.
- (4) Cased to 145, Size 2"
- (5) Screen: Size 1 1/4", Length 6'
- (6) Were any formations sealed against pollution?
_____ yes, _____ no.

If YES depth of formation _____

Why _____

Drillers Remarks: _____

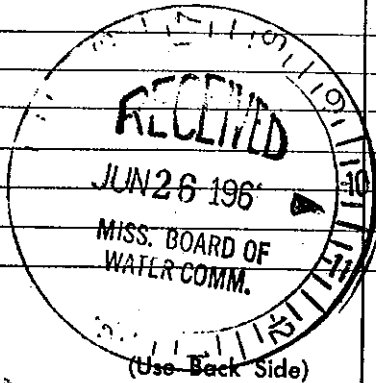

Well No. _____

Retain this copy for your office files.