

COMMISSIONERS

GRENADA.

WATER WELL DRILLERS LOG

CODED

(?)

Grenada

Date: 3-6-62
3-6-62

Driller: James R. Lyle
(Name)

County: Paria

(1) Owner of Land:	Description & Color of Materials Sand, Clay, Red Clay, Shell, etc.	Thick- ness Feet	Depth Feet
(Name) <u>Jay Taylor</u> (Address) <u>Grenada, Miss</u>	<u>Red clay & sand rock</u>	<u>0</u>	<u>15</u>
(2) Location: <u>1/4, 1/4, Sec. 11 T²³R⁴E</u>	<u>clay & clay</u>	<u>15</u>	<u>100</u>
<u>10</u> miles <u>North</u> of <u>Grenada</u>	<u>car. & clay</u>	<u>100</u>	<u>108</u>
(3) Topography: <u>Hilly</u>	<u>expanding sand</u>	<u>108</u>	<u>118</u>
(4) Purpose of Well: <u>Domestic</u>			


Information upon completion of well:

- (1) Diameter 2 inches.
- (2) Total Depth 118 feet.
- (3) Water Level 30 feet below top of ground.
- (4) Cased to 105, Size 2"
- (5) Screen: Size 1 1/4', Length 6'
- (6) Were any formations sealed against pollution?
 yes, no.

If YES depth of formation _____

Why _____

Drillers Remarks: _____

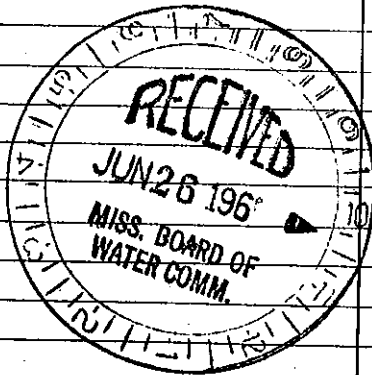

Well No.

(Use Back Side)

Retain this copy for your office files.