

WATER WELL DRILLERS LOG

GRENADA

Date: July 5 1963 Driller: James R. Sipe County: Panola
07-5-63 (Name)

CODED

(1) Owner of Land: <u>Ed McLannon</u> (Name)	Description & Color of Materials Sand, Clay, Red Clay, Shell, etc.	Thick- ness Feet	Depth Feet
<u>Grenada, Miss.</u> (Address)	top soil	0	25
(2) Location: <u>1/4, 1/4, Sec. 2 23 24</u> <u>2</u> miles <u>West</u> of <u>Hardy</u> (distance) (direction) (Nearest Town)	gravel	25	35
(3) Topography: <u>Hilly</u> (Hilly) (Flat) (Level)	gravel & sand	35	60
(4) Purpose of Well: <u>Domestic</u> (Domestic Irrigation Municipal, Industrial, Other)	fine gravel	60	80
	clay & sand	80	100
	gravel & sand w/sand	100	115
		115	125


Information upon completion of well:

- (1) Diameter 2" inches.
- (2) Total Depth 125' feet.
- (3) Water Level 72' feet below top of ground.
- (4) Cased to 116', Size 2"
- (5) Screen: Size 1/4", Length 6'
- (6) Were any formations sealed against pollution?
 yes, no.

If YES depth of formation _____

Why _____

Drillers Remarks: _____

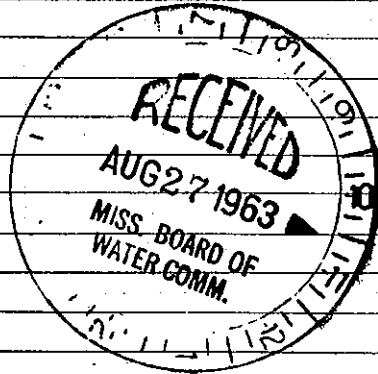

Well No. _____

(Use Back Side)

Retain this copy for your office files.