

GRENADE MISSISSIPPI BOARD OF WATER COMMISSIONERS

A9

11-24-61

WATER WELL DRILLERS LOG

A-300

Date: 11-24, 1961, Driller: J B Cain County Grenada
(Name)

(1) Owner of Land	Description & Color of Materials Sand, Clay, Red Clay, Shell, etc.	Thick- ness Feet	Depth Feet
<u>Samuel Ymont</u> <small>(Name)</small>	<u>Clay</u>	<u>0</u>	<u>22</u>
<u>ROV. 1 SCOPY MISS</u> <small>(Address)</small>	<u>Loam</u>	<u>22</u>	<u>105</u>
(2) Location: <u>1/4</u> Sec. <u>3-23N</u> <u>10</u> miles <u>NORTH</u> of <u>GERNADA</u> <small>(distance) (direction) (Nearest Town)</small>	<u>water sand</u>	<u>105</u>	<u>120</u>
(3) Topography: <input checked="" type="checkbox"/> (Hilly) <input type="checkbox"/> (Flat) <input type="checkbox"/> (Level)	<u>COPIED</u>		
(4) Purpose of Well: <u>for HOME</u> <small>(Domestic Irrigation Municipal, Industrial, Other)</small>			

Information upon completion of well:


- (1) Diameter 2 inches.
- (2) Total Depth 120 feet.
- (3) Water Level 67 feet below top of ground.
- (4) Cased to 120, Size 2"
- (5) Screen: Size 1/4, Length 6 FT
- (6) Were any formations sealed against pollution?
 yes, no.

If YES depth of formation _____

Why _____

Drillers Remarks: _____

This well is along the N center of Sect 3 - on the Yalipushie + Grenada County line
(Use Back Side)

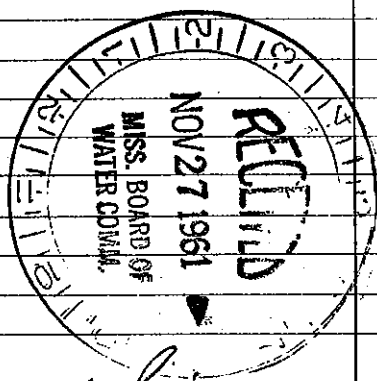

Well No. _____