

GRENADA
A10

WATER WELL DRILLERS

CODED

Date: 11-11, 1962, Driller: Luther Hatyc County, Grenada
(Name)

(1) Owner of Land: J. R. Ross
(Name)

Pewridge, Miss
(Address)

(2) Location: 1/4, 1/4, Sec. 18 23 R 4

 miles of
(distance) (direction) (Nearest Town)

(3) Topography:
(Hilly) (Flat) (Level)

(4) Purpose of Well:
(Domestic Irrigation
Municipal, Industrial, Other)

Description & Color of Materials Sand, Clay, Red Clay, Shell, etc.	Thick- ness Feet	Depth Feet
Clay + Sand	0	25
Sand + Gravel	25	47
Gravel	47	69
Sand + Gravel	69	91
Gravel	91	113
Sand + Shale	113	135
Shale + Sand	135	157
Shale + Sand	157	179
Sand + Shale	179	201
Shale + Sand	201	223
Shale + Clay	223	245
Clay	245	311

Information upon completion of well:

(1) Diameter 2" inches.

(2) Total Depth 311 feet.

(3) Water Level 119 feet below top of ground.

(4) Cased to 311, Size 2"

(5) Screen: Size 2", Length 10'


(6) Were any formations sealed against pollution?
 yes, no.

If YES depth of formation

Why

Drillers Remarks:

CODED

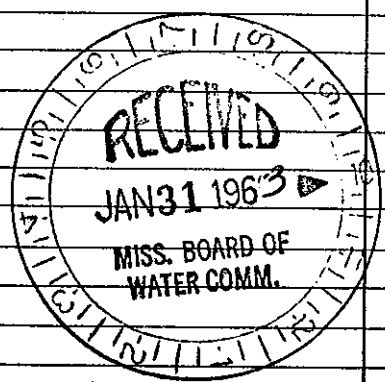

(Use Back Side)

Well No.

Mail this copy to Board of Water Commissioners 429 Miss. St. Jackson, Miss.