

WATER WELL DRILLERS LOG

CODED

~~St. Vincent~~ **ST. VINCENT & THE GRENADINES**

Date: ~~9-11-63~~ 9-11-63, 19 ~~63~~ **63** Driller: James R. Lyle County St. Vincent
 (Name)

9-11-63

(1) Owner of Land:	Description & Color of Materials Sand, Clay, Red Clay, Shell, etc.	Thick- ness Feet	Depth Feet
(Name) <u>Jose Strider</u>	<u>Clay</u>	<u>0</u>	<u>35</u>
(Address) <u>Archie, Mas.</u>	<u>Clay & gravel</u>	<u>35</u>	<u>45</u>
(2) Location: <u>1/4, 1/4, Sec. 5 P²³R⁴</u>	<u>gravel</u>	<u>45</u>	<u>60</u>
<u>6 miles west</u> of <u>Harby</u>	<u>gravel & sand</u>	<u>60</u>	<u>90</u>
(3) Topography: <u>Hilly</u>	<u>clay sand</u>	<u>90</u>	<u>117</u>
(4) Purpose of Well: <u>Domestic</u>			


Information upon completion of well:

- (1) Diameter 2 inches.
- (2) Total Depth 117 feet.
- (3) Water Level 60 feet below top of ground.
- (4) Cased to 111, Size 2"
- (5) Screen: Size 1 1/4, Length 6'
- (6) Were any formations sealed against pollution?
 yes, no.

If YES depth of formation _____

Why _____

Drillers Remarks: _____

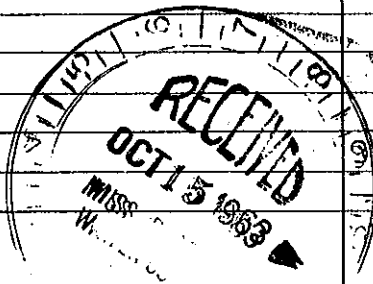

(Use Back Side)

Well No. _____

Retain this copy for your office files.