

**GRENADA MISSISSIPPI BOARD OF WATER COMMISSIONERS**

A 2000

5-2-64

**WATER WELL DRILLERS LOG**

GRENADA

Date: 5-2, 1964, Driller: J B Cain

County: ~~Franklin~~

(Name)

(1) Owner of Land:	Description & Color of Materials Sand, Clay, Red Clay, Shell, etc.	Thick- ness Feet	Dep'th Feet
M Mc Cellan (Name) S Cokey (Address) 30 27 A	Bad Cl Sand + shell	0	51
(2) Location: 1/4, 1/4, Sec. 30 T 23N R 4E			
8 miles N W of Grenada (distance) (direction) (Nearest Town)			
(3) Topography: (Hilly) (Flat) (Level)			
(4) Purpose of Well: Home (Domestic Irrigation Municipal, Industrial, Other)			


Information upon completion of well:

- (1) Diameter 2 inches.
- (2) Total Depth 110 feet.
- (3) Water Level 78 feet below top of ground.
- (4) Cased to 110, Size 2"
- (5) Screen: Size 1/4, Length 6 FT
- (6) Were any formations sealed against pollution?  
\_\_\_\_\_ yes, \_\_\_\_\_ no.

If YES depth of formation \_\_\_\_\_

Why \_\_\_\_\_

Drillers Remarks: \_\_\_\_\_

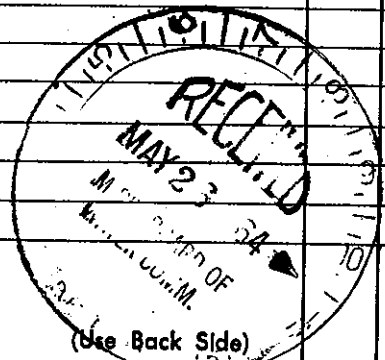

Well No. \_\_\_\_\_

Mail this copy to Board of Water Commissioners 429 Miss. St. Jackson, Miss.