Grenada					
Permit #: MS-6w-16/53					
Irrigation Equipment					
Date drilling completed: $8-5-04$					

State Well Report

Part 1

Mississippi Department of Environmental Quality
Office of Land and Water Resources
P.O. Box 10631
Jackson, MS 39289-0631
(601)961-5210
(601)354-6938 (fax)

43
For Office Use Only:
Aquifer: Bl04
L. S. Elevation:
E-log #:

State Law requires that this report be prepared by the driller in detail and filed with the Department within 30 days of completion of drilling of the well.

30 days of completion of drilling of the well.						
Well Owner Information PUNKEN CKERK LP Owner Name Bailey & Son Farms	Well Location					
0	Latitude:°' Longitude:°'"					
Mailing Address: 691 Airl Industrial Park Ro	Method of Lat/Long (circle one): Conventional Survey,					
orland 38655	, USGS quad, Hand-held GPS, Survey-grade GPS					
Grenada, MS 38901	SW 14 NE 14 Sec 32 Twn 23N Rng 5E					
City State Zip Code						
Telephone No. (662-226-0850 Coley Bailey	Distance Direction Nearest Town 4 Miles NE of Grenada					
Well D	Data					
Purpose of Well (circle one) Home Industrial Dublic Sumula	Replacement					
Purpose of Well (circle one) Home Industrial Public Supply Date well drilling started: 8-5-04 Date w	rish Culture Other: GW - 8-98					
•						
If flowing, method of flow regulation: Valve Other (de						
Static Water Level: 9ft. feet above o below (circle one) la	and surface Date measured: 8-6-04					
Method of Measurement (circle one) steel tape electric tape						
Hole depth: 155' Well depth: 155'						
Type of grout (circle one): Cement Bentonite Mix						
Casing length: 115 feet Casing diameter: 16	inches Type of casing PVC Sch. 40					
Screen length: 40 feet Screen diameter: 16	inches Type of screen: PVC Sch. 40					
Screen slot size:	116 feet to 155 feet					
Type of completion (circle all applicable): Cravel packet Under	reamed Telescoped Open hole Natural Development					
Other (describe):						
Top of lap pipe or reduction in casing:feet. If telescoped or more than one screen, describe on back of page						
Logs run (circle all applicable): No log run Electric Gamma Ray Density Sonic Neutron Other:						
Name of organization running log(s):						
I certify that the well was drilled, constructed, and completed in accordance with all applicable requirements of the Mississippi						
Department of Environmental Quality and/or the Mississippi Department of Health regulations and state laws.						
Irrigation Equipment Inc. Patrick M. Chism 0695 Patrick M. Chism 0695						
Print Name of Water Well Contractor and License No.	Signature of Water Well Contractor					

AUG 1 3 2004

BY: OLWR


Ground Level

B	_	1	0	4
ل	~	l	U	7

Description of Formations Encountered	From	To
Clay	0	18
Fine Sand	19	25
Fine Sand/gravel	26	45
Fine Sand/clay	46	55
Clay	56	74
Fine Sand/clay	75	85
Clay	86	112
Fine Sand	1113	150
Clay	151	155
		<u> </u>
<u> </u>		<u> </u>
		<u> </u>
,		<u> </u>
		1

If more than one screen, show location of each on sketch

Sketch the property layout and include the following: 1) the well location; 2) any permanent structures on the property that may aid in locating the well; 3) any roads, power lines, or other items that may aid in locating the property and the well; 4) indicate direction.

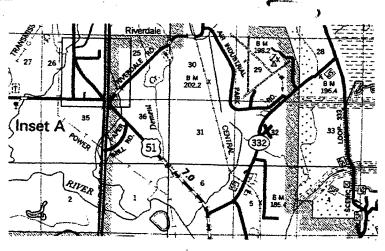

Landowner Name:

Bailey & Son Farms

Patrick M Chrom

Signature of Water Well Contractor

STATE WELL REPORT

Part 2

Pump Installer's Completion Report
Mississippi Department of Environmental Quality
Office of Land and Water Resources
P.O. Box 10631
Jackson, MS 39289-0631
(601)961-5210
(601)354-6938 (fax)

For Office Use Only:				
Aquifer:				
Well#: B-104				
Elevation:				

This report should be prepared by the pump installer in detail and filed with the Department within 30 days of the installation of pump.

PUNCIN CREEK LP	Well Location	
Owner Name: Railey & Son	Latitude:Longitude:	
Mailing Address: 1/2 Douglas DAIVE	Method of Lat/Long (circle one): Conventional Survey,	
Oxford 38655 Grenada, MS 38901	USGS quad, Hand-held GPS, Survey-grade GPS SW 14 NE 14 Sec 32 Twn 23N Rng 5E	
City State Zip Code		
662-226-0850	Distance Direction Nearest Town	
Telephone No. ()	4 NE Grenada of	
	L	

	Pump Type Circle one			Power Type Circle one	
Air Lift	Jet	Submersible	Diesel Engine	Gasoline Engine	Natural Gas
Bucket	Piston	Turbine	Electric Motor	Hand	Tractor PTO
Centrifugal	Rotary	Flowing Well	Windmill	Other (specify):	
Other (specify):			Horse Power Rating	g of Motor: 60	
Date Pump Installed:	8-6-04		Setting Depth:	80	feet
Rated Pump Capacity: _	2200	Gallons Per Minute	Number of Stages:	2	

Pump Test Data	Method of Measuring Water Level Circle one		
Date Well Tested: 8-6-04			
Static Water Level (A):Feet Below Land Surface	Air Line Electric Measuring Line Steel Tape		
Pumping Water Level (B):Feet Below Land Surface	Other (specify):		
Drawdown [(B) - (A)]:Feet Below Land Surface	For flowing well, measured shut in head:feet		
Test Pumping Rate:Gallons Per Minute ~	Well yieldedGPM with a drawdown of		
Duration of Pump Test (minimum 4 hours):hours	feet afterhours of pumping		

:	HEREBY CERTIFY that	t the above st	atements are true to the	best of my knowledger	
	Patrick M.		0695	Patrick M	ChANDECEIVED
L	Print Name of Pump Instal	ller and Licen	se No. (if applicable)	Signature of Pump Ins	taller