

GRENA DA MISSISSIPPI BOARD OF WATER COMMISSIONERS

WATER WELL DRILLERS LOG

C 2000
7-20-64

Date: July 20, 1964, Driller: Robert F. Rathoff County: Grenada
(Name)

	Description & Color of Materials Sand, Clay, Red Clay, Shell, etc.	Thick- ness Feet	Depth Feet
(1) Owner of Land: <u>T. J. Wright</u> (Name) <u>Goat Spring</u> (Address)	Red + Blue clay + Red	0	22
	Blue clay	22	44
	Blue clay	44	66
(2) Location: <u>75 R 6</u>	well hole	66	88
<u>7</u> miles <u>North</u> of <u>Goat Spring</u> (distance) (direction) (Nearest town)	Shale Rock 103	88	109
	Shale + Rock	109	131
(3) Topography: <u>Hilly</u> (Hilly) (Flat) (Level)	Shale + Red	131	153
	Shale + Red	153	175
(4) Purpose of Well: <u>Domestic</u> (Domestic Irrigation Municipal, Industrial, Other)	Shale	175	197
	Shale	197	218
	Shale + Red 233'	218	240
	Shale + Red 265'	240	319
	Sandy gravel	319	339
	Sand + Shale streaks	339	335

Information upon completion of well:

(1) Diameter 4x2 inches.

(2) Total Depth 335 feet.

(3) Water Level 142 feet below top of ground.

(4) Cased to 335, Size 4x2


(5) Screen: Size 2, Length 5'

(6) Were any formations sealed against pollution?
✓ yes, _____ no.

If YES depth of formation Cased

Why _____

Drillers Remarks: _____

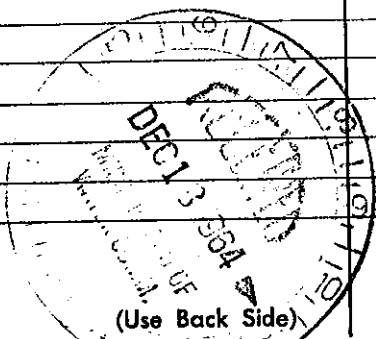

Well No.

Mail this copy to Board of Water Commissioners 429 Miss. St. Jackson, Miss.