

State Well Report

Part 1

Mississippi Department of Environmental Quality
Office of Land and Water Resources
P.O. Box 10631
Jackson, MS 39289-0631
(601)961-5210
(601)354-6938 (fax)

For Office Use Only:

Aquifer: _____
Well #: E-34
L. S. Elevation: _____
E-log #: _____

County: Grenada
Permit #: GW 42273
Driller: COOK Drilling
Date drilling completed: Jan 16, 08

State Law requires that this report be prepared by the driller in detail and filed with the Department within 30 days of completion of drilling of the well.

Well Owner Information	Well Location
Owner Name: <u>Little + Little</u>	Latitude: <u>33° 47' 43"</u> Longitude: <u>90° 03' 45"</u>
Mailing Address: <u>12268 Hwy West</u> <u>Holcomb MS</u>	Method of Lat/Long (circle one): <u>Conventional Survey</u>
<u>Holcomb MS 38945</u> City State Zip Code	USGS quad, Hand-held GPS, Survey-grade GPS
Telephone No: <u>662, 226-3108</u>	<u>1/4</u> <u>1/4</u> Sec <u>11</u> Twn <u>22N</u> Rng <u>2E</u>
	Distance Direction Nearest Town <u>5</u> Miles <u>W</u> of <u>Holcomb</u>

Well Data	
Purpose of Well (circle one): Home Industrial Public Supply <u>Irrigation</u> Fish Culture Other: _____	
Date well drilling started: <u>1-16-08</u> Date well drilling completed: <u>1-16-08</u>	
If flowing, method of flow regulation: Valve _____ Other (describe) _____	
Static Water Level: <u>15</u> feet above or below (circle one) land surface Date measured: <u>1-18-08</u>	
Method of Measurement (circle one): <u>steel tape</u> electric tape air line other: _____	
Hole depth: <u>62'</u> Well depth: <u>62'</u> Well grouted to a depth of <u>10'</u> feet	
Type of grout (circle one): <u>Cement</u> Bentonite Mix	
Casing length: <u>52'</u> feet Casing diameter: <u>42"</u> inches Type of casing: <u>PVC</u>	
Screen length: <u>20'</u> feet Screen diameter: <u>12"</u> inches Type of screen: <u>PVC</u>	
Screen slot size: <u>150</u> inches Setting depth: From <u>42</u> feet to <u>62</u> feet	
Type of completion (circle all applicable): <u>Gravel packed</u> Underreamed Telescoped Open hole Natural Development Other (describe): _____	
Top of last pipe reduction in casing: _____ feet. If telescoped or more than one screen, describe on back of page	
Logs run (circle all applicable): No log run Electric Gamma Ray Density Sonic Neutron Other: _____	
Name of organization running log(s): _____	

I certify that this well was drilled, constructed, and completed in accordance with all applicable requirements of the Mississippi Department of Environmental Quality and/or the Mississippi Department of Health regulations and state laws.

Sidney Cook Drilling Co. Inc.
Print Name of Well Contractor and License No. 289

Sidney Cook
Signature of Water Well Contractor

Faint, illegible text at the top of the page, possibly a header or introductory paragraph.

1977.10.10

Main body of faint, illegible text, possibly a list or detailed notes.

44

6W42273

Ground well




Description of Formations Encountered

From To

Description of Formations Encountered	From	To
Sandy Clay	Top	40'
sand & shale	40'	62'

If more than one screen, show location of each on sketch

Sketch the property layout and include the following: 1) the well location; 2) any permanent structures on the property that may aid in locating the well; 3) any roads, power lines, or other items that may aid in locating the property and the well; indicate direction.

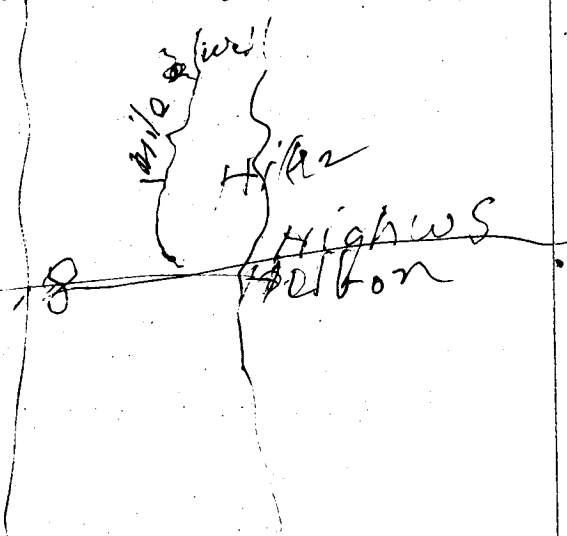

Landowner Name Little & Little

Lubner Cook
Signature: Water Well Contractor

STATE WELL REPORT

Part 2

Pump Installer's Completion Report
 Mississippi Department of Environmental Quality
 Office of Land and Water Resources
 P.O. Box 10631
 Jackson, MS 39289-0631
 (601)961-5210
 (601)254-6938 (fax)

For Office Use Only:

Aquifer: _____

Well #: E-34

Elevation: _____

County: Okefenokee
 Permit #: GW 42273
 Driller: _____
 Date completed: 1-18-08

This report should be prepared by the pump installer in detail and filed with the Department within 30 days of the installation of pump.

Well Owner Information		Well Location	
Owner Name: <u>Little, Little</u>	Latitude: <u>33-47-43N</u>	Longitude: <u>90-03-45W</u>	
Mailing Address: <u>12268 Highway West</u>	Method of Lat/Long (circle one): <u>Conventional Survey</u>		
<u>Holcomb</u>	USGS quad, Hand-held GPS, Survey-grade GPS		
<u>Holcomb</u> <u>MS</u> <u>38940</u>	_____ 1/4 _____ 1/4 Sec _____ Twn _____ Rng _____		
City State Zip Code	Distance _____	Direction _____	Nearest Town _____
Telephone No. <u>662 226-3108</u>	<u>5</u> Miles <u>SW</u> of <u>Holcomb</u>		

	Pump Type Circle one		Power Type Circle one		
	Air Lift	Jet	<u>Submersible</u>	Diesel Engine	Gasoline Engine
Bucket	Piston	Turbine	<u>Electric Motor</u>	Hand	Tractor PTO
Centrifugal	Rotary	Flowing Well	Windmill	Other (specify): _____	
Other (specify): _____			Horse Power Rating of Motor: <u>20</u>		
Date Pump Installed: <u>1-18-08</u>			Sealing Depth: <u>50</u> feet		
Rated Pump Capacity: <u>450</u> Gallons Per Minute			Number of Stages: <u>2</u>		

	Pump Test Data		Method of Measuring Water Level Circle one	
	Date Well Tested: _____		Air Line	Electric Measuring Line
Static Water Level (A): _____ Feet Below Land Surface		Other (specify): _____		
Pumping Water Level (B): _____ Feet Below Land Surface		For flowing well, measured shut in head: _____ feet		
Drawdown ((B)-A): _____ Feet Below Land Surface		Well yielded _____ GPM with a drawdown of _____ feet after _____ hours of pumping		
Test Pumping Rate: _____ Gallons Per Minute				
Duration of Pump Test (minimum 4 hours): _____ hours				

I HEREBY CERTIFY that the above statements are true to the best of my knowledge.

Sidney Cook's Drilling Co. Inc. Sidney Cook
 Print Name of Installer and License No. (if applicable) 289 Signature of Pump Installer

BY _____