

GRENA DA MISSISSIPPI BOARD OF WATER COMMISSIONERS


6-62

WATER WELL DRILLERS LOG

OR
W H S

Date: June, 1962, Driller: Robert E. Rathoff County Grenada
(Name)

(1) Owner of Land:	Description & Color of Materials Sand, Clay, Silty Clay, Shell, etc.	Thick- ness Feet	Depth Feet
<u>Chas. W. Gravel</u> (Name)	<u>Gravel</u>	<u>0</u>	<u>115</u>
<u>Halecamp, Miss.</u> (Address)	<u>Shale + Rock</u>	<u>115</u>	<u>136</u>
(2) Location: _____ 1/4, _____ 1/4, Sec. _____ T _____ R _____	<u>Shale + Sand</u>	<u>136</u>	<u>152</u>
_____ miles _____ of _____ (distance) (direction) (Nearest Town)	<u>Shale + Sand</u>	<u>152</u>	<u>180</u>
(3) Topography: <input checked="" type="checkbox"/> (Hilly) <input type="checkbox"/> (Flat) <input type="checkbox"/> (Level)	<u>Shale + Rock</u>	<u>180</u>	<u>222</u>
(4) Purpose of Well: <u>Wash Gravel</u> (Domestic Irrigation, Municipal, Industrial, Other)	<u>Sand + Shale</u>	<u>222</u>	<u>244</u>
Information upon completion of well:	<u>Sand + Shale</u>	<u>244</u>	<u>310</u>
(1) Diameter <u>8</u> inches. <u>442' of 8"</u>	<u>Shale</u>	<u>310</u>	<u>331</u>
(2) Total Depth <u>487</u> feet.	<u>Sand + Shale</u>	<u>331</u>	<u>375</u>
(3) Water Level <u>80'</u> feet below top of ground.	<u>Shale</u>	<u>375</u>	<u>418</u>
(4) Cased to <u>487</u> , Size <u>42' of 4"</u>	<u>Shale + Sand</u>	<u>418</u>	<u>462</u>
(5) Screen: Size <u>4"</u> , Length <u>40</u>	<u>Sand</u>	<u>462</u>	<u>484</u>
(6) Were any formations sealed against pollution? _____ yes, <input checked="" type="checkbox"/> no.			
If YES depth of formation _____			
Why _____			
Drillers Remarks: _____			

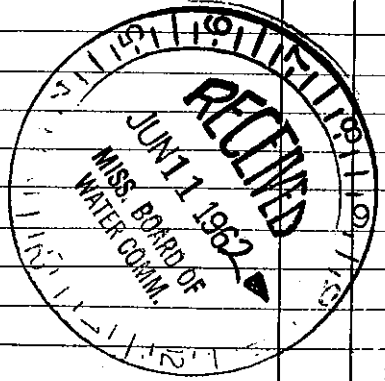

Well No.

(Use Back Side)

Mail this copy to Board of Water Commissioners 429 Miss. St. Jackson, Miss.