

GRENADA

WATER WELL DRILLERS LOG

Date: 12-1-62, 1962, Driller: Luther Rathiff, County Grenada (Name)


(1) Owner of Land: Robert Dunn (Name)	Description & Color of Materials Sand, Clay, Red Clay, Shell, etc.	Thick- ness Feet	Depth Feet
Hobson, Miss (Address)	Clay + Sand	0	25
(2) Location: 1/4, 1/4, Sec. T R	Clay + Sand	25	47
miles of	Sand	47	69
(distance) (direction) (Nearest Town)	Sand	69	91
(3) Topography: (Hilly) (Flat) (Level)	Sand	91	113
(4) Purpose of Well: Domestic (Domestic Irrigation, Municipal, Industrial, Other)	Sand + Clay	113	135
	Sand + Shale	135	157
	Shale + Clay	157	179
	Clay	179	201
	Clay + Sand	201	223
	Sand	223	224

Information upon completion of well:

- (1) Diameter 2 inches.
- (2) Total Depth 241 feet.
- (3) Water Level 170 feet below top of ground.
- (4) Cased to 241, Size 2"
- (5) Screen: Size 2", Length 10'
- (6) Were any formations sealed against pollution?  
yes, no.

If YES depth of formation  
Why

Drillers Remarks:

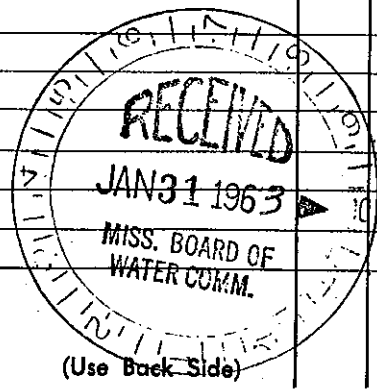

Well No.

Mail this copy to Board of Water Commissioners 429 Miss. St. Jackson, Miss.